


T.14S.R.39E.WM

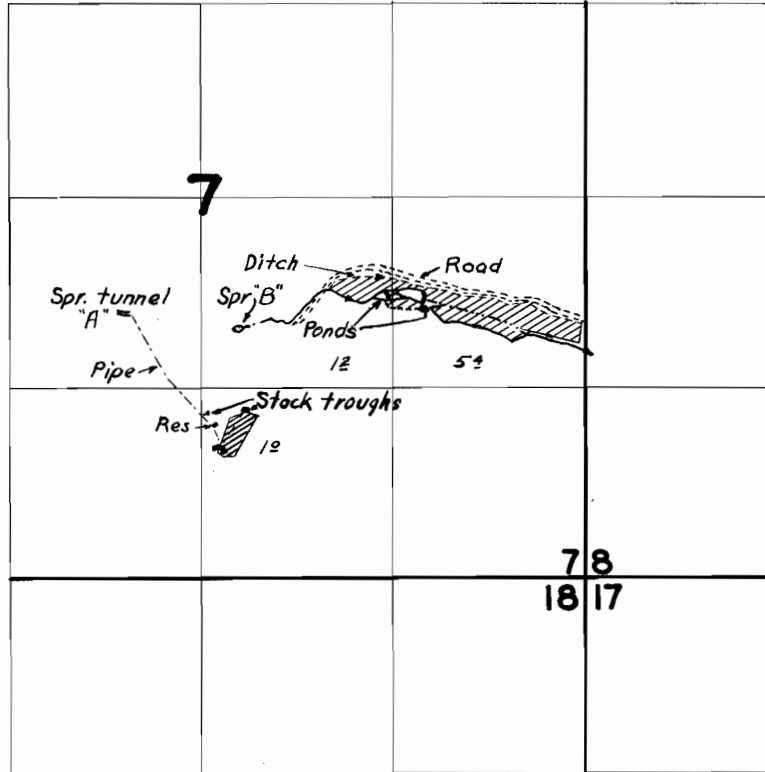

FINAL PROOF SURVEY

UNDER

25472

2-1106

Application No. 25175 Permit No. 19255

IN NAME OF

.....

Surveyed 1925, by