


# T.14S.R.39E.WM

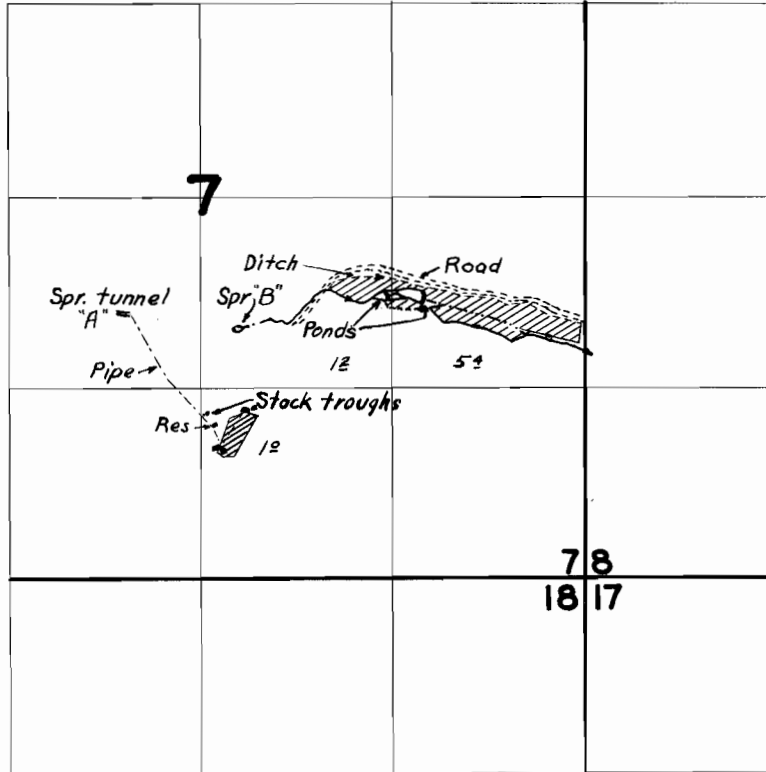

## FINAL PROOF SURVEY

UNDER

2572

2-1106

Application No. 2-175 Permit No. 12255

IN NAME OF

.....

Surveyed ..... 19... by .....