
T. 35 S., R. 2 W., W.M.

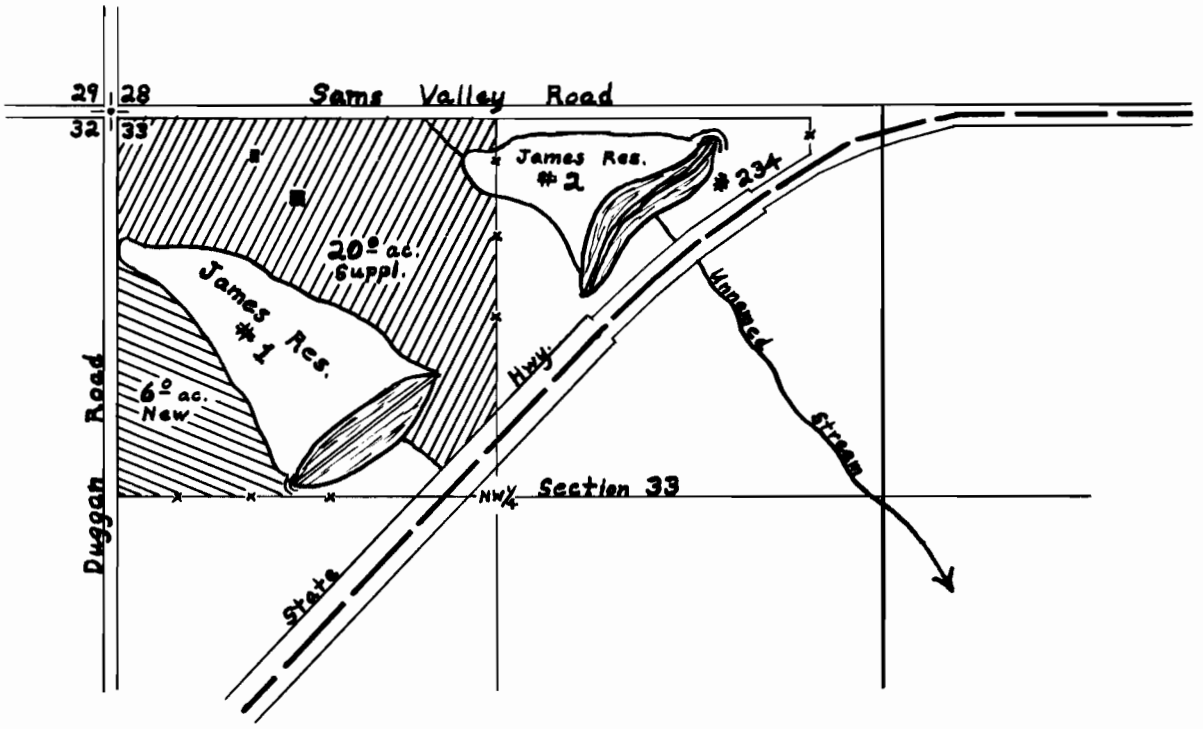

Scale: 8 inches = 1 mile

FINAL PROOF SURVEY

UNDER

Application No. R-30574 Permit No. R-1855

IN NAME OF

Lester E. James

Surveyed March 14, 1958, by D.C. Hendrix, W.M.

R1385

T. 40 & 41 S. R. 16 E. W.M.

R-1385

20337

R 25205
25367

R 1385
21503

HENRY ALBERTSON

MAY 14 59
NOV. 1 1960

