


15539

T. 2 N. R. 10 E. WM

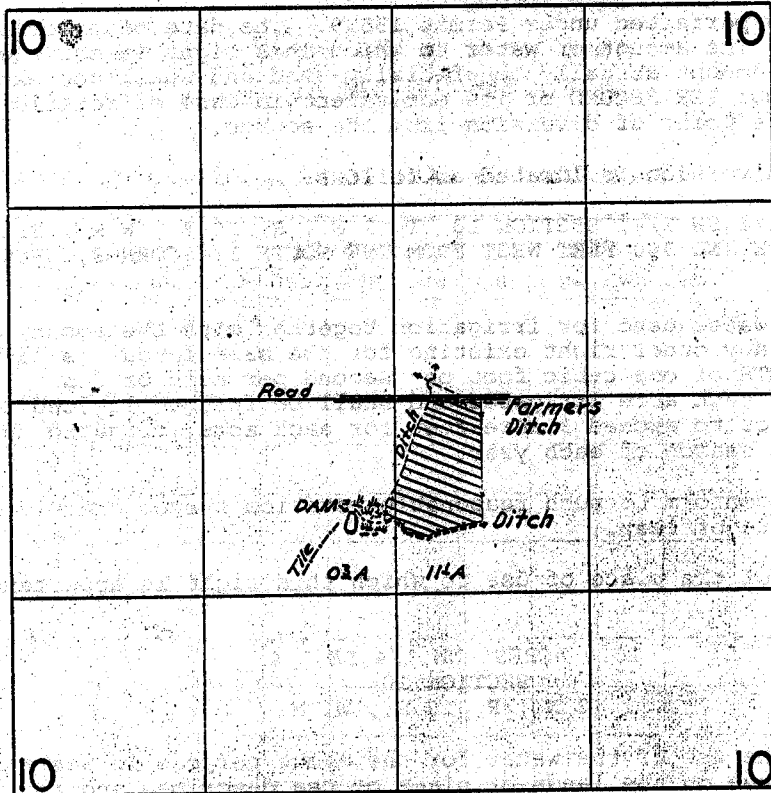

FINAL PROOF SURVEY UNDER

Application No. 19969 Permit No. 15539

IN NAME OF

J. E. & VELMA R. KING

Surveyed June 11 1953 by T. Jones