


**T.26 S.R.13 W.W.M.**

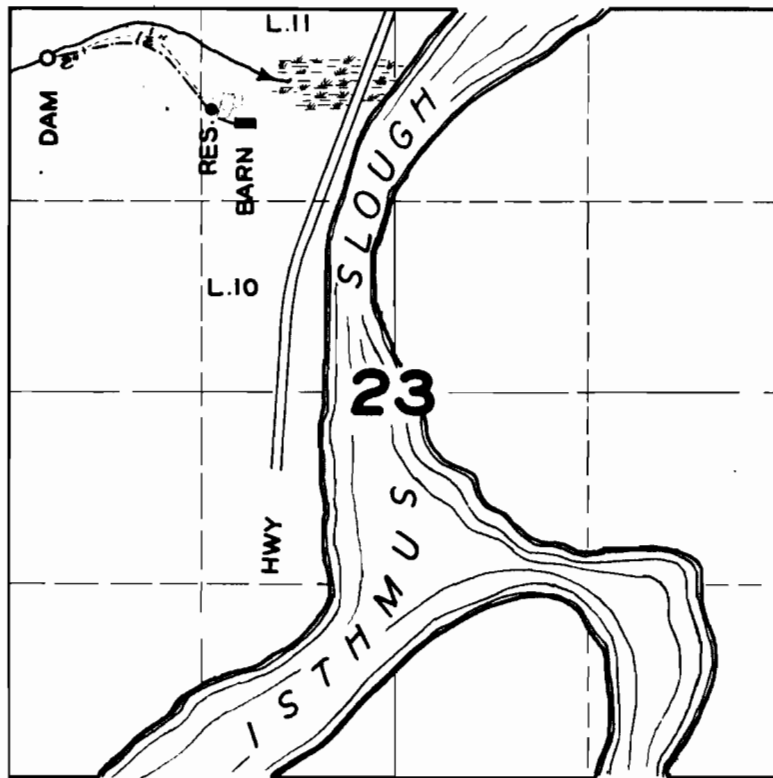

**FINAL PROOF SURVEY**

UNDER

Application No. 20067 Permit No. 15630.

IN NAME OF

PHILIP LEHL & GEORGE YOST.

Surveyed SEP. 9 1949, by H.L. COFFMAN.