


North

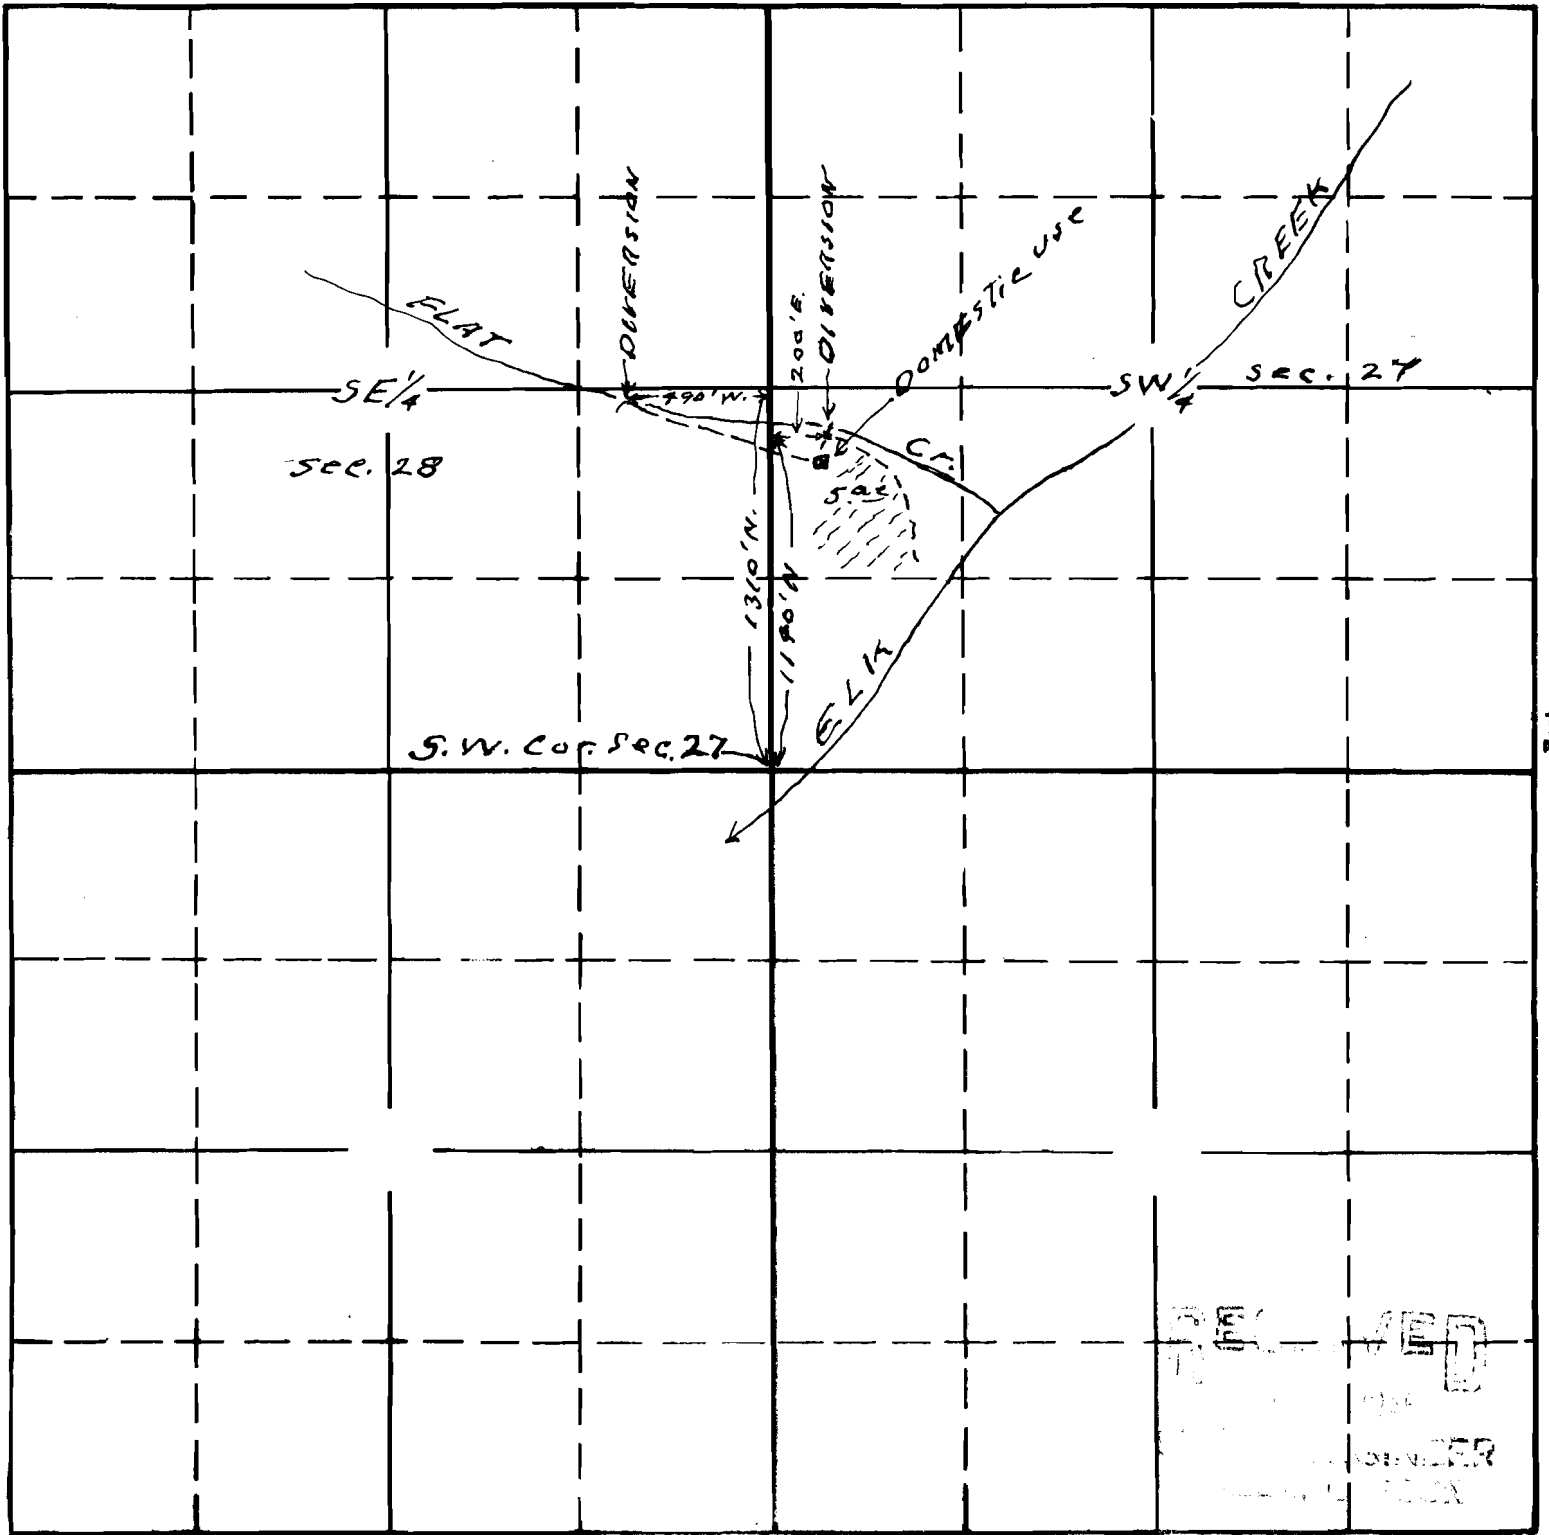

South

21326

15-782

RECEIVED
 CIVIL ENGINEER
 1915

Map to accompany application of
 G.B. Hughes for use of waters from
 Flat Creek for irrigation and
 domestic purposes.

APPLICATION No. 21326
 PERMIT No. 16722

This office 12/11/45 *[Signature]*