


T.6S.R.2E.WM

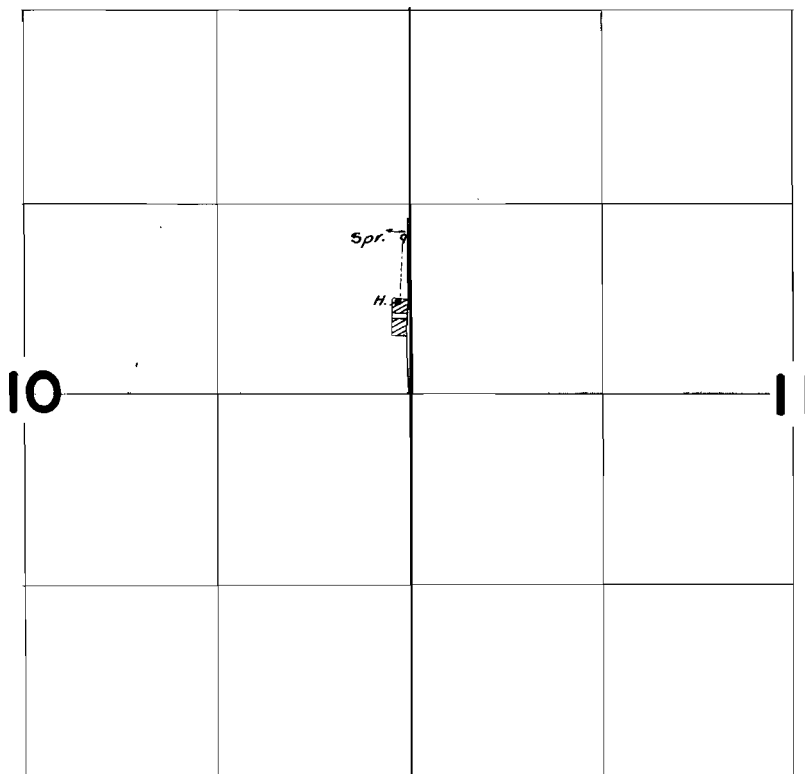

FINAL PROOF SURVEY

UNDER

Application No. 22368 Permit No. 17635

IN NAME OF

LOA SHILTS

Surveyed July 2 1953, by T. Jones