
T. 3 S., R. 2 E., W.M.

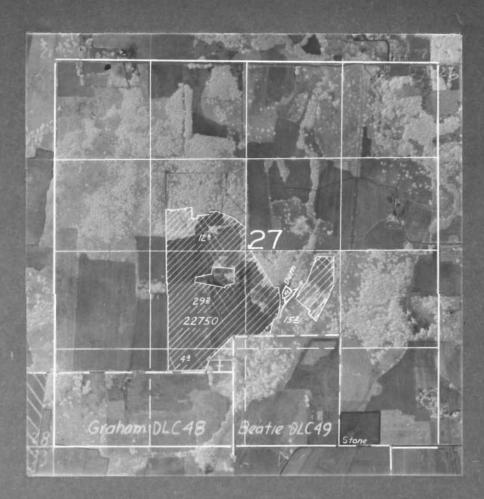

FINAL PROOF SURVEY

UNDER

Application No. 22750 Permit No. 18323 IN NAME OF

JOE PAVLINAC

Surveyed May 25 1953, by H. L. Coffman