


T.6S.R.IE.WM

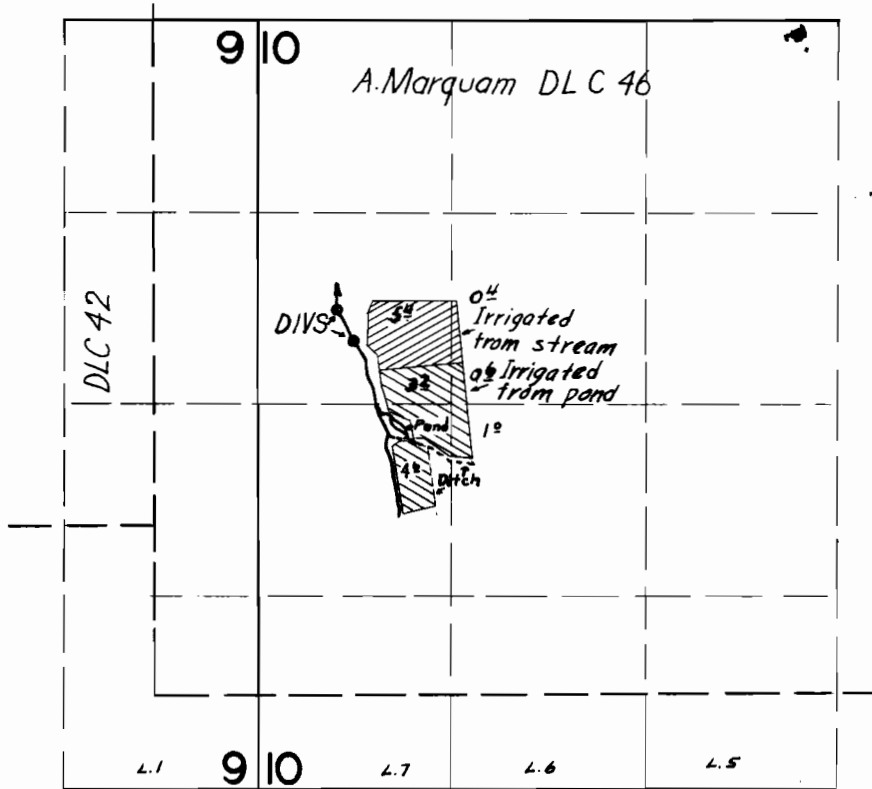

FINAL PROOF SURVEY UNDER

Application No. 23790 Permit No. 18767

IN NAME OF

MRS. PAULINE SWARTOUT

Surveyed July 2 1953, by T. Jones