


T.6S. R.2E.WM

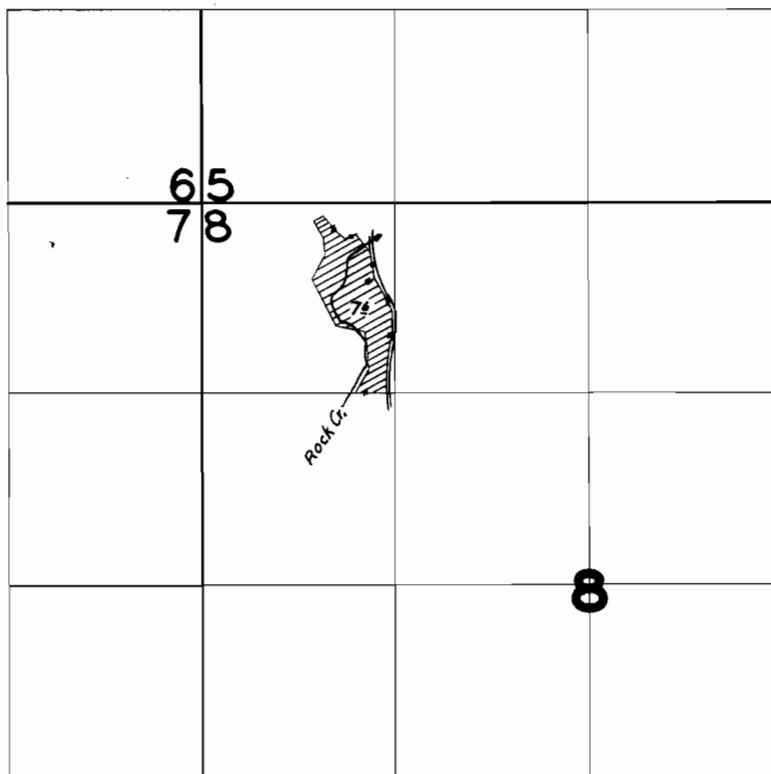

FINAL PROOF SURVEY

UNDER

Application No. 25201 Permit No. 19810

IN NAME OF

AGNES E. ROWE

Surveyed July 1 1953, by T. JONES

1953Z