


# T.27S. R.2&3W. WM

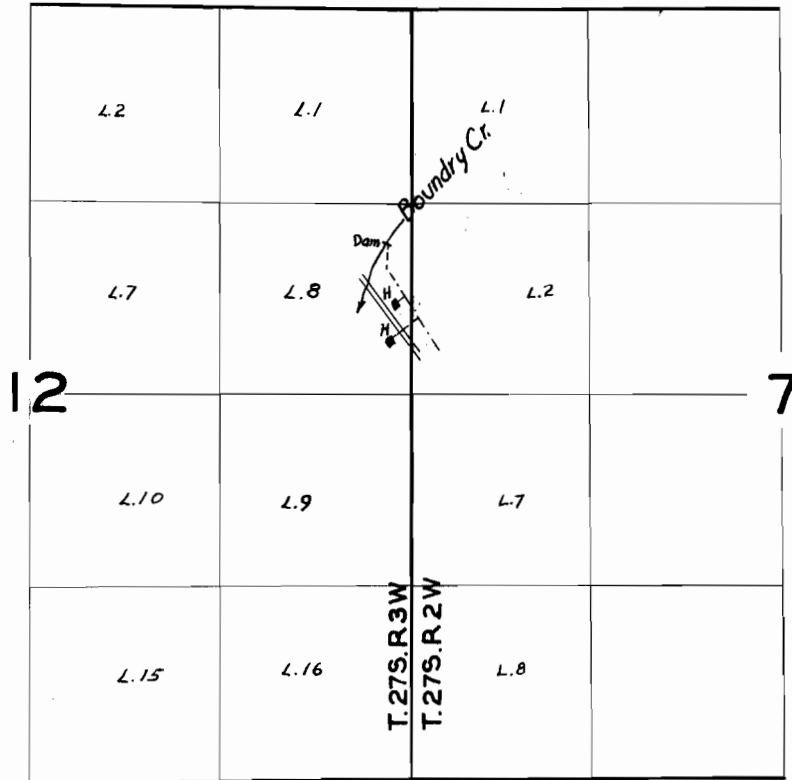

## FINAL PROOF SURVEY UNDER

Application No. 25101 Permit No. 19755

IN NAME OF

IKE S. ALLEN

Surveyed Sept. 4 1953, by H. L. Coffman