


T.36S.R.12E WM

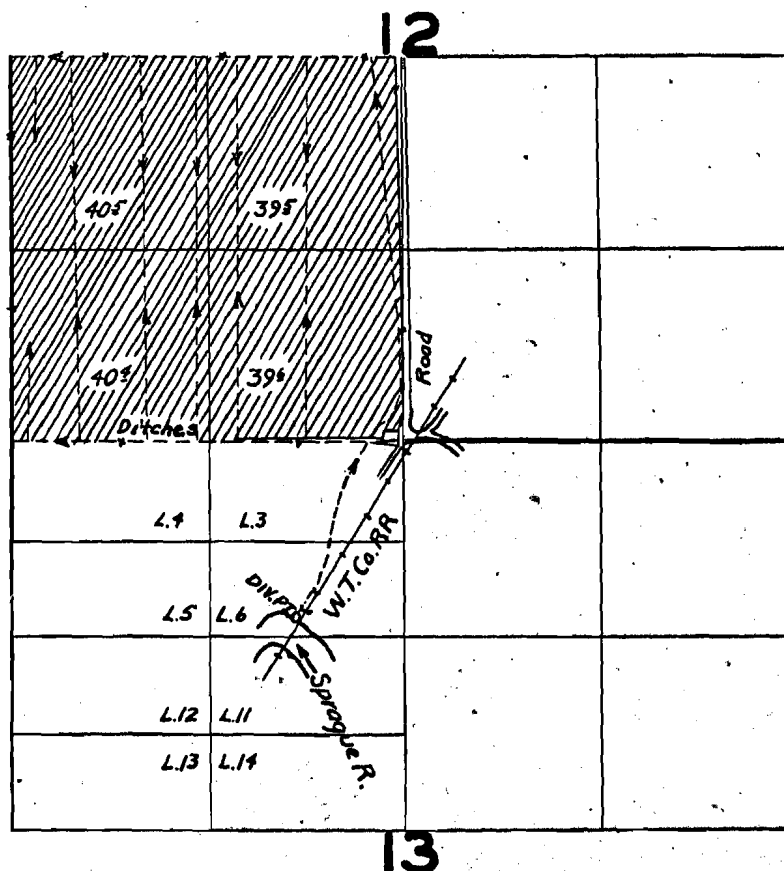

FINAL PROOF SURVEY

UNDER

Application No. 25697..... Permit No. 20248.....
IN NAME OF

Frank and Nellie Mae Krizo

Surveyed Aug. 11, 1953, by H.L. Coffman