


T. I. S. R. 4 W. W. M.

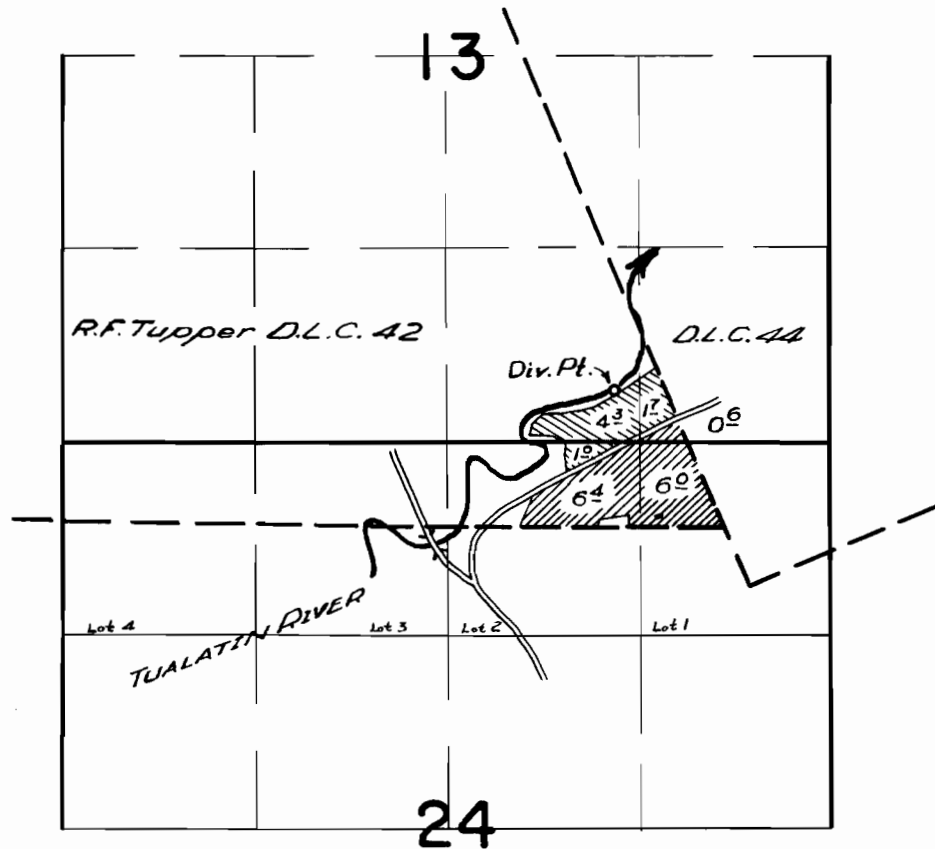


FINAL PROOF SURVEY UNDER

Application No. 22237 25620 Permit No. 17503 20098
IN NAME OF

MRS. VIRGINIA BRIDGES

Surveyed April 15, 1952, by H.L. Coffman

T. 1 S., R. 4 W., W.M.

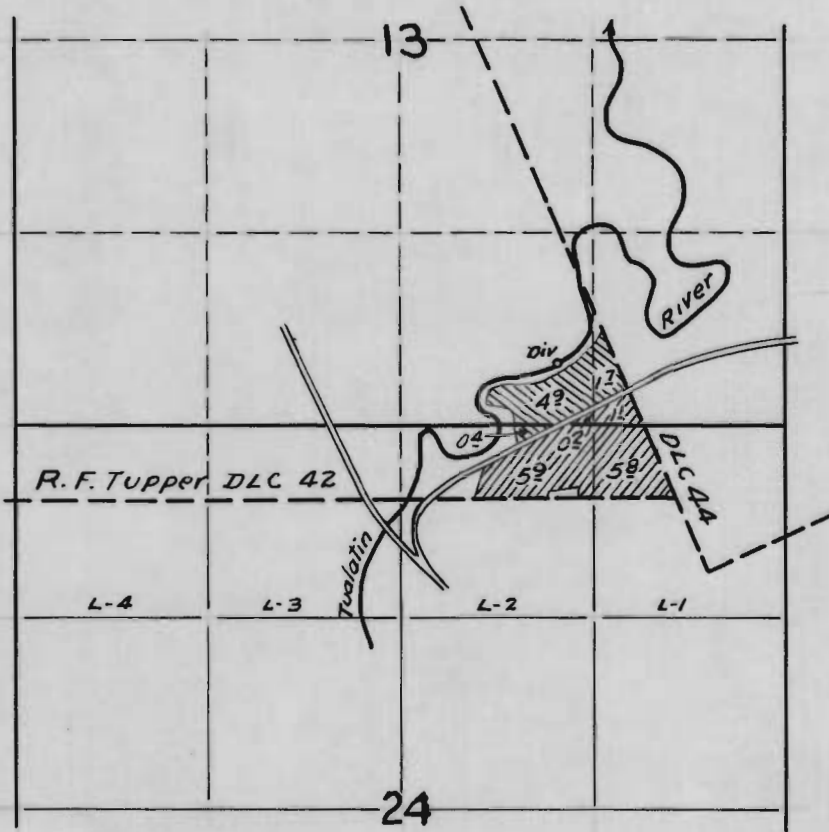

Superseded
See Corrected Map

FINAL PROOF SURVEY

UNDER


Application No. 22237 25620 Permit No. 17503 20098

IN NAME OF

Mrs. Virginia Bridges

Surveyed 4-15 1952, by H.L. Coffman

T. I. S. R. 4 W. W. M.

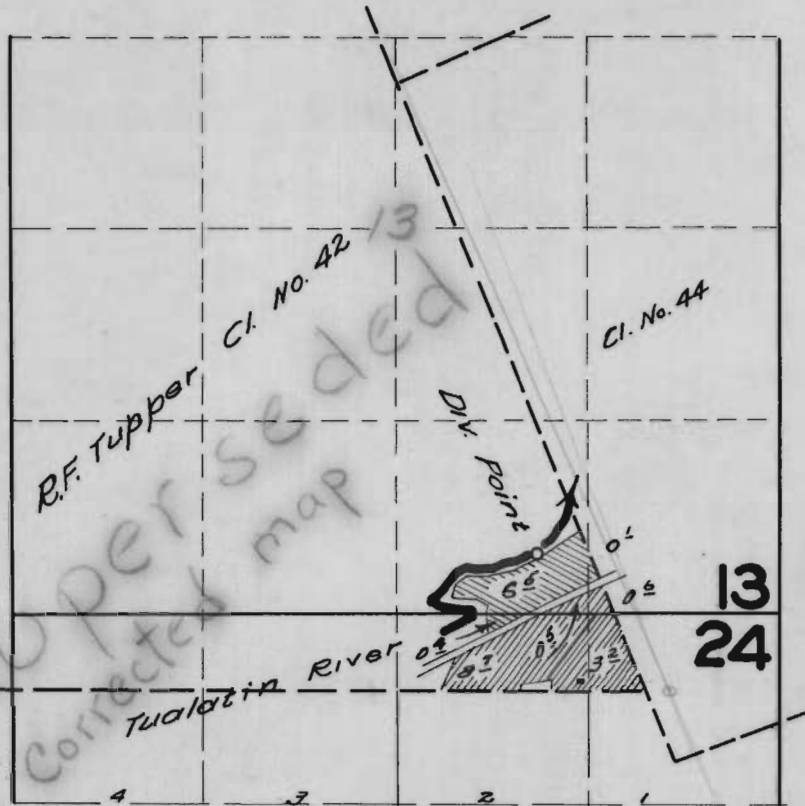

FINAL PROOF SURVEY

UNDER

25620

20098

Application No. 22237

Permit No. 17503

IN NAME OF

Mrs. VIRGINIA BRIDGES

Surveyed 4 / 15 1952, by H. L. COFFMAN