


11 E.W.M


Permit U-534

U-2:  
21236

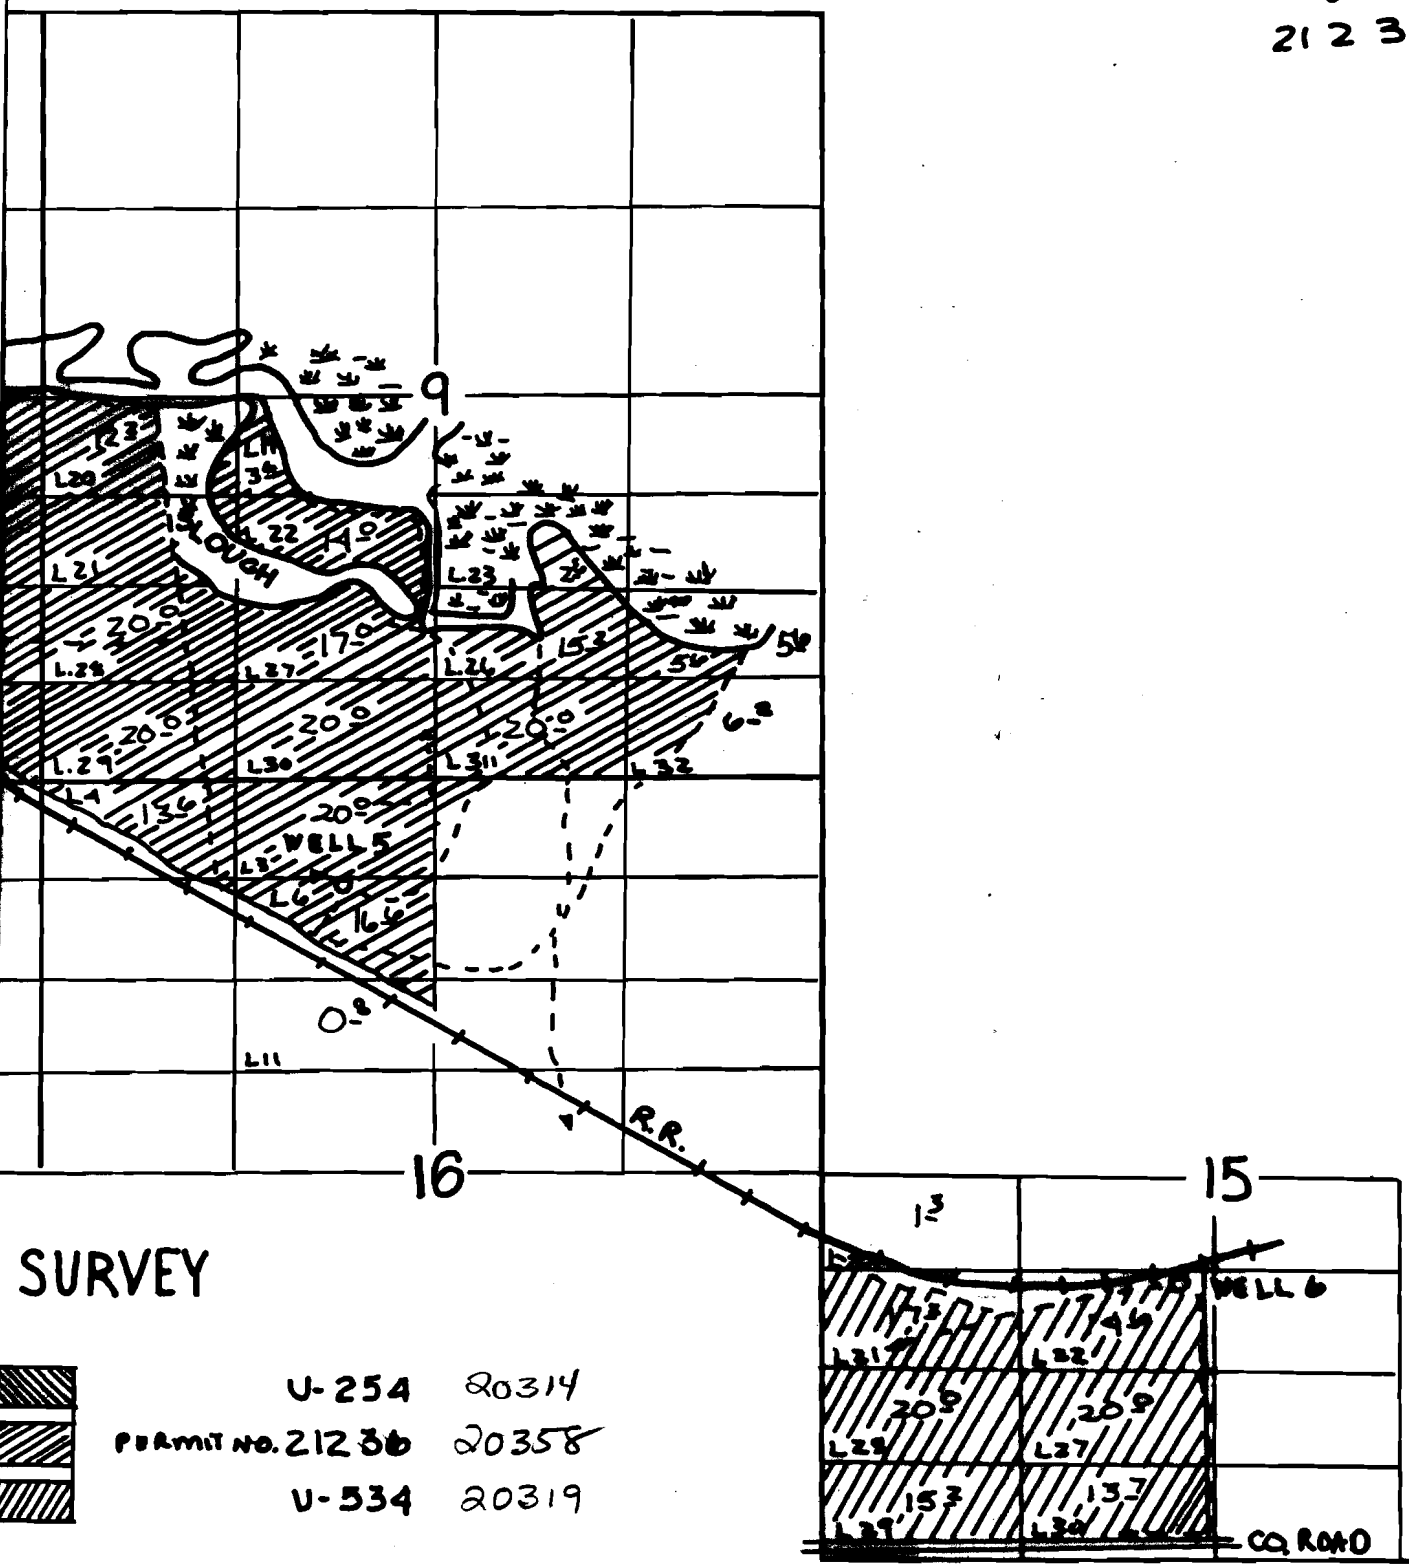

Virginia Goularte

T.36 S. R

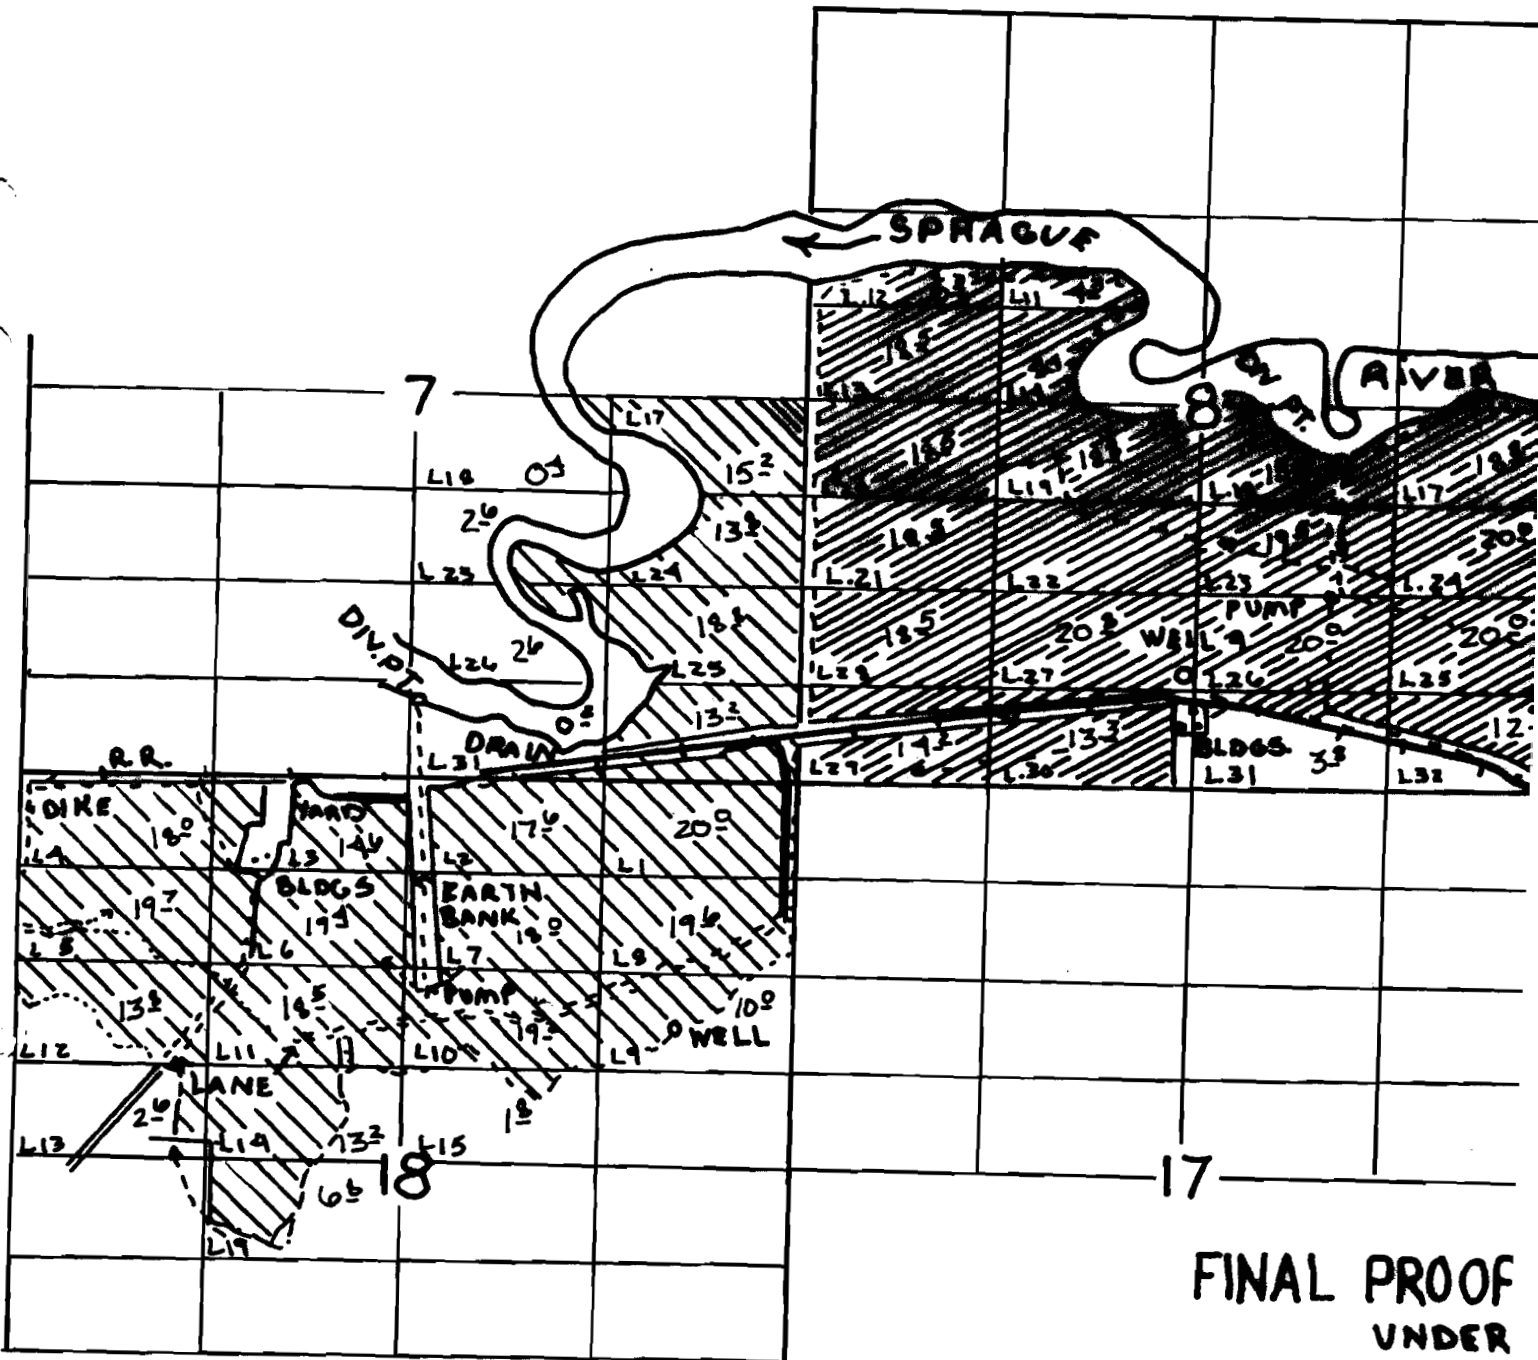

FINAL PROOF  
UNDER

U-244

APPLICATION NO. 25643

U-585

IN NAME OF

D.M.Hess

Frank &