

P. 2045
C2036


7028

R. Cram Pipe Line

CROOK COUNTY OREGON

Scale 2" = 1 Mile

T. 9 S. R. 15 E.

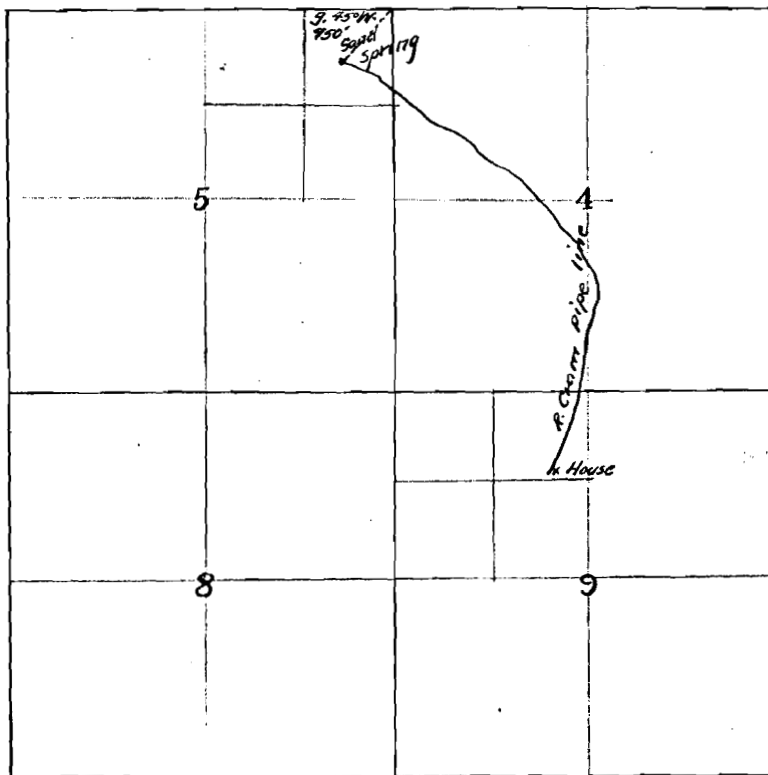

RECEIVED
APR 18 1914.
SALEM, OREGON.

Application No. 360
Permit No. 2045.

P # 2045

7028

7028