


21864
20364

T.33S. R.7 1/2 E.WM

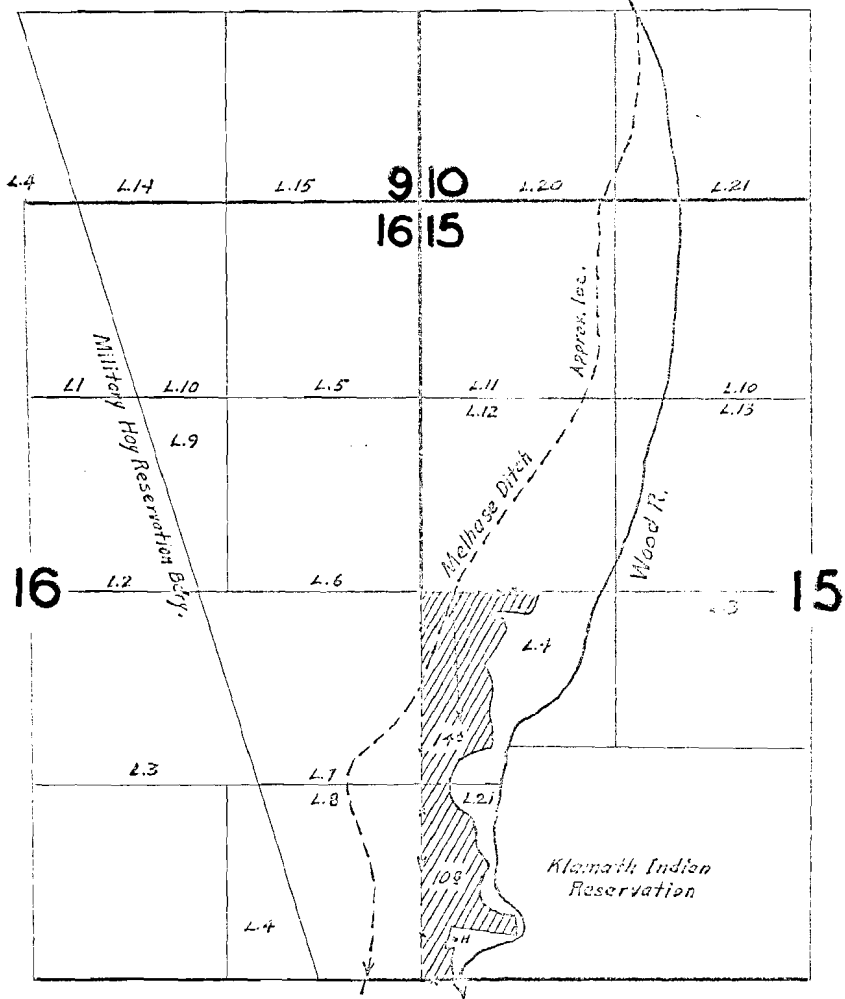

FINAL PROOF SURVEY UNDER

Application No. 775 Permit No. 2
IN NAME OF

J.P. McAuliffe

Surveyed 19..... by

wood River