


T.16S.R.43E.WM

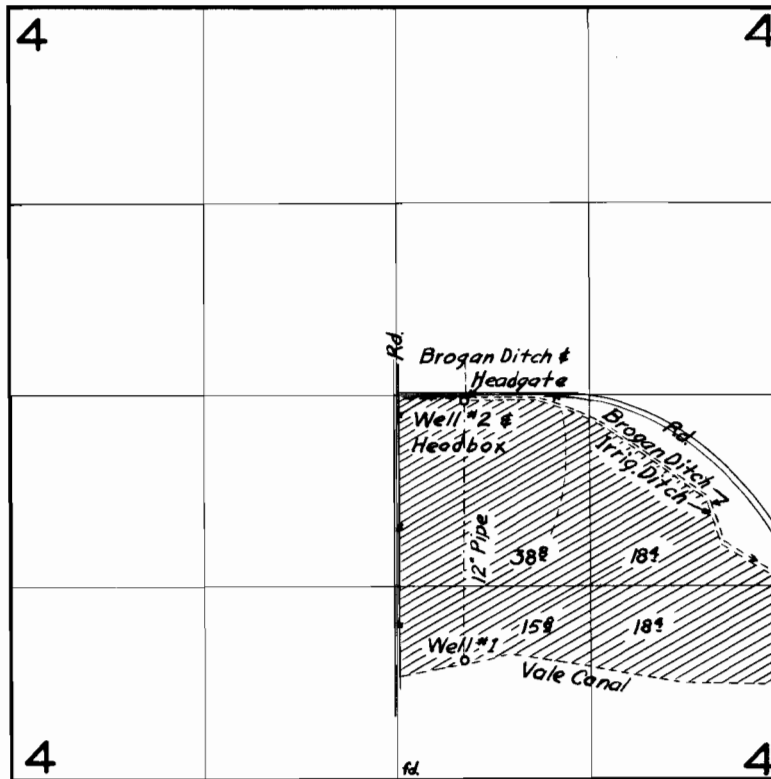

FINAL PROOF SURVEY

UNDER

U-535

U-491

Application No. U-536

Permit No. U-492

IN NAME OF

W. V. & LESSIE GAYNELL JOHNSTON

Surveyed July 20 1953, by T. Jones