


T. 4 S., R. 3 E., W.M.

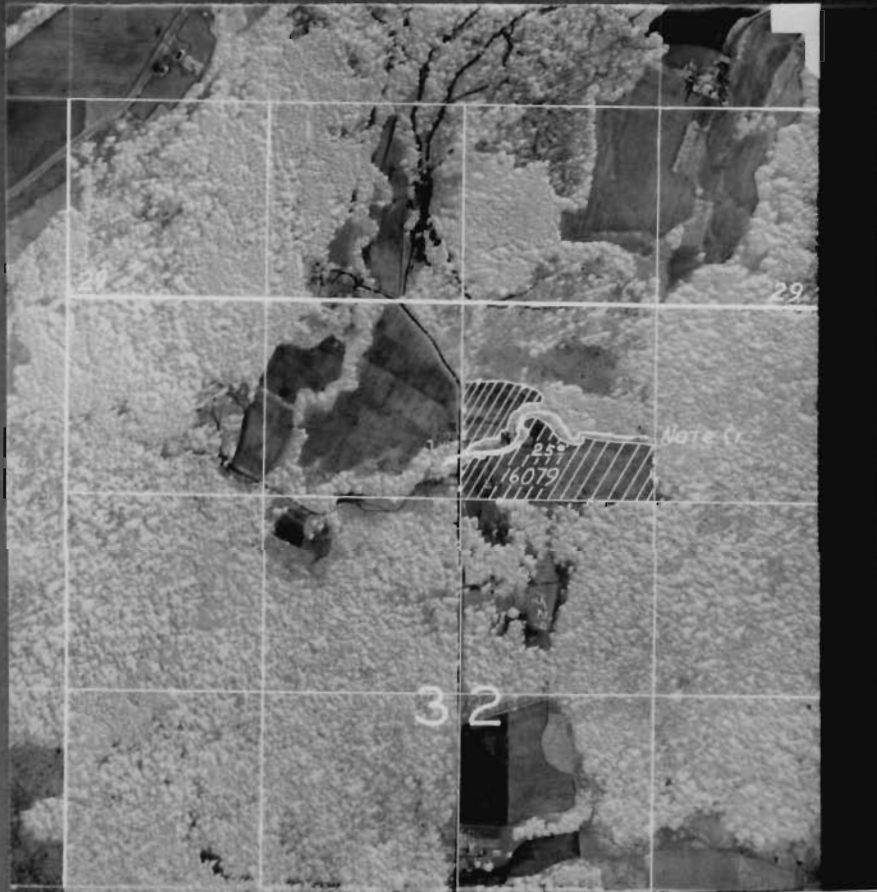

FINAL PROOF SURVEY
UNDER

Application No. 16079 Permit No. 11879
IN NAME OF

FRANK S. & ELEANOR HILGER

Surveyed June 3 1953, by H. I. Coffman

DFK-1D-90