


24379

T. 4 S., R. 1 E., W.M.

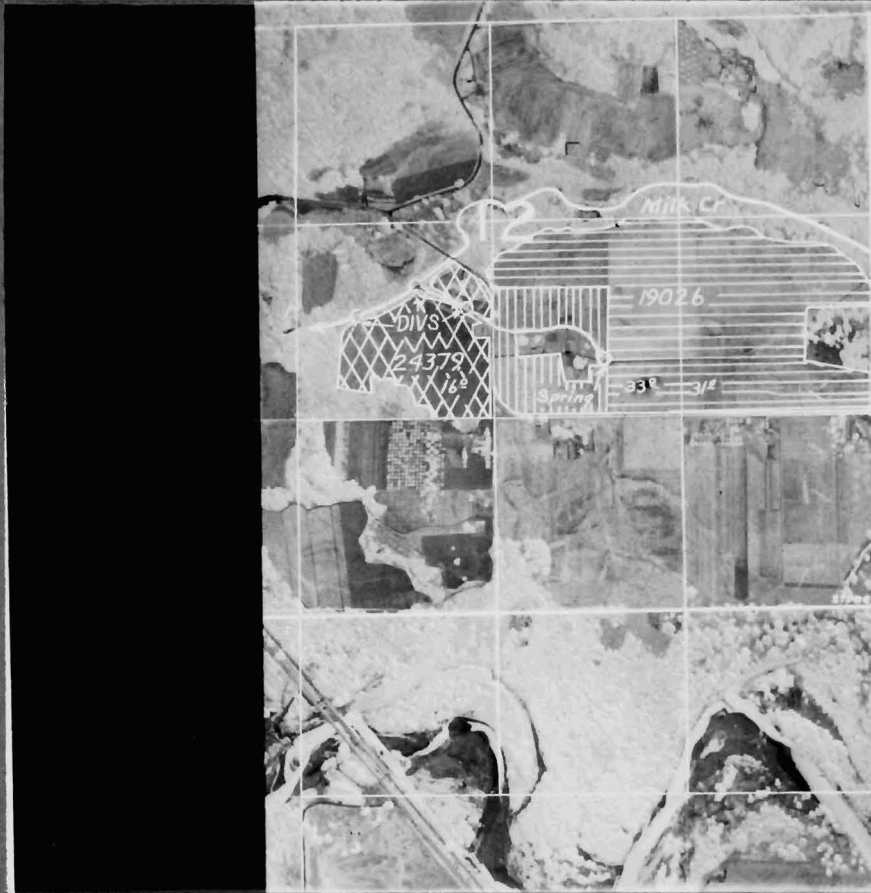

# FINAL PROOF SURVEY

UNDER

19026

11633

Application No. 24379

Permit No. 19145


IN NAME OF  
L. RUTHERFORD

FRANK SPERB

Surveyed May 26, 1953, by H. L. Coffman

DFK-3D-121

# T.4S.R.1E.W.M.

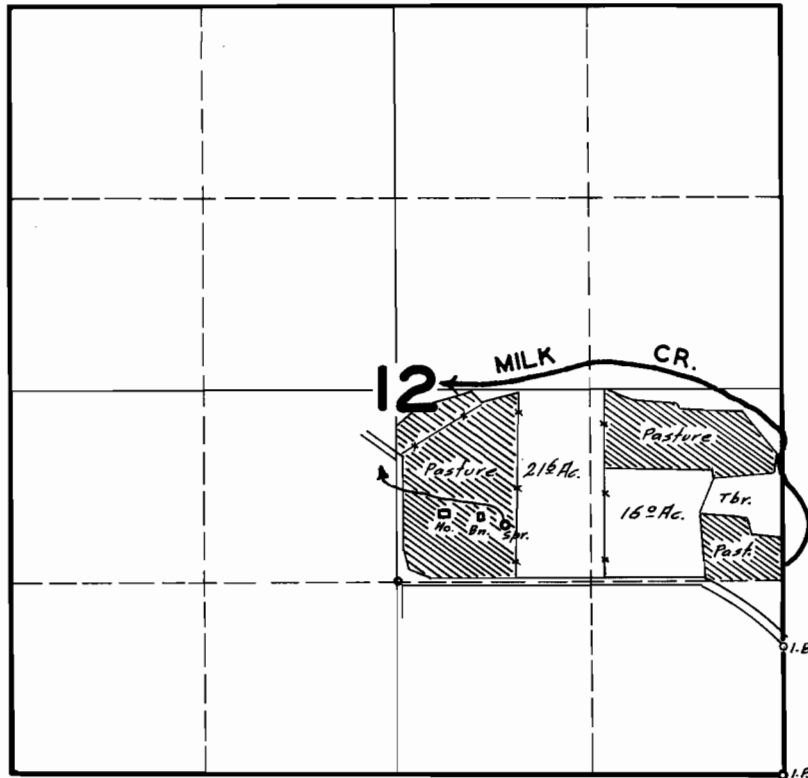

## FINAL PROOF SURVEY UNDER

Application No. 19026 Permit No. 14633

IN NAME OF

L. RUTHERFORD

Surveyed OCT. 6, 1947, by JAS. E. BUNNELL