


T13&14S, R. 6 W., W.M.

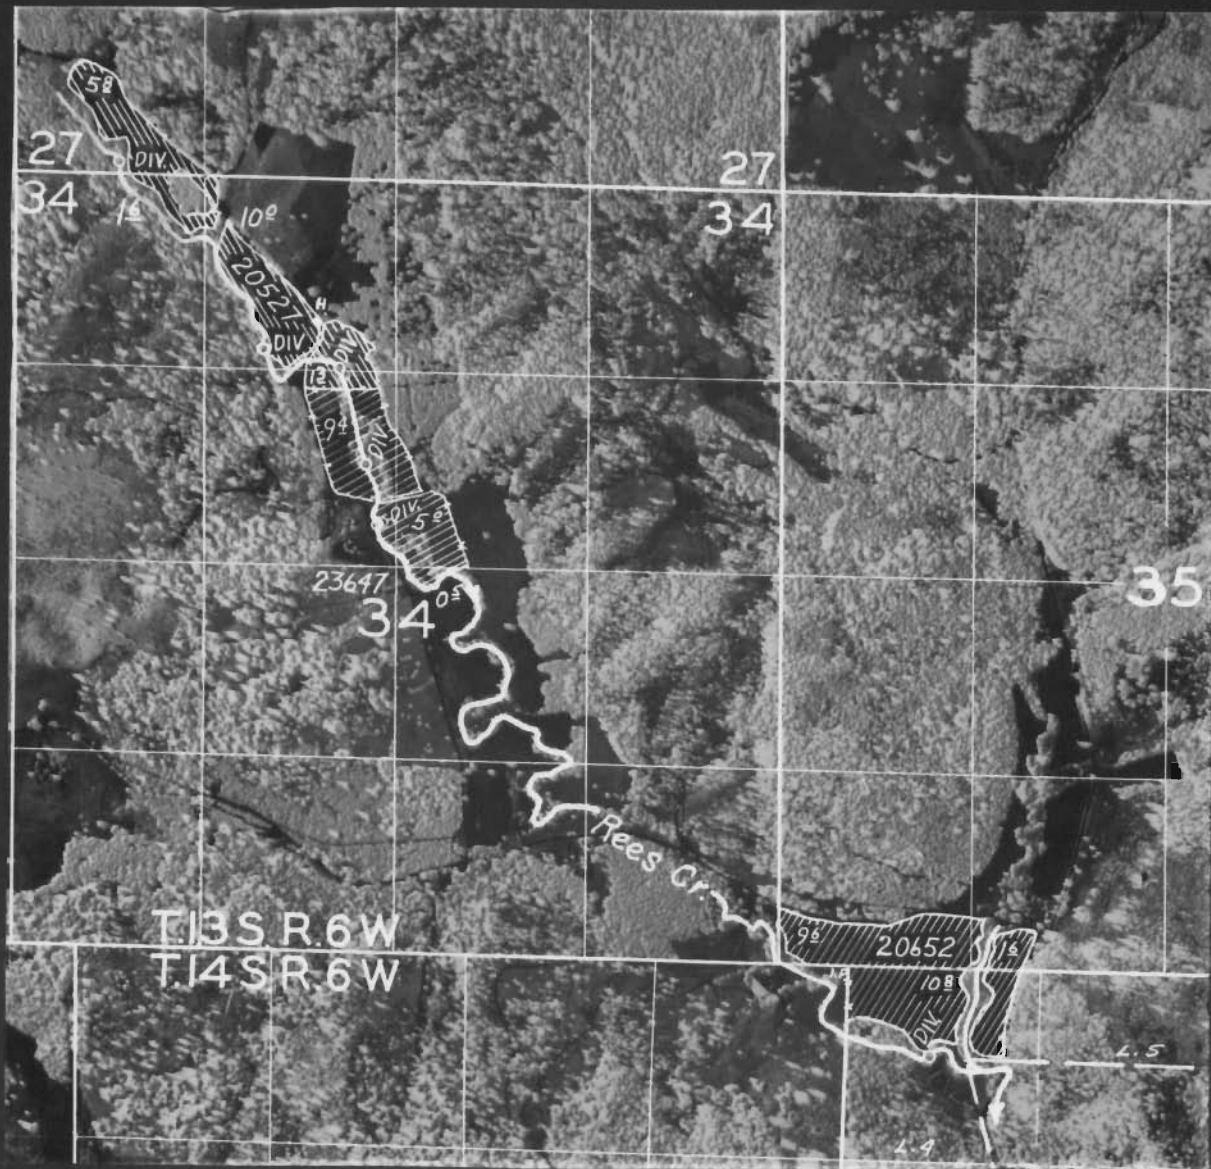

### FINAL PROOF SURVEY

UNDER

Application No. <sup>20527</sup>20652 Permit No. <sup>16027</sup>16154

IN NAME OF

Clarence & Lucille E Wilson

Nile J. Pearce

Richard Parker

Surveyed Aug 5, 6, 19 53, by H.L. Coffman