


T.36S.R.14 W.WM

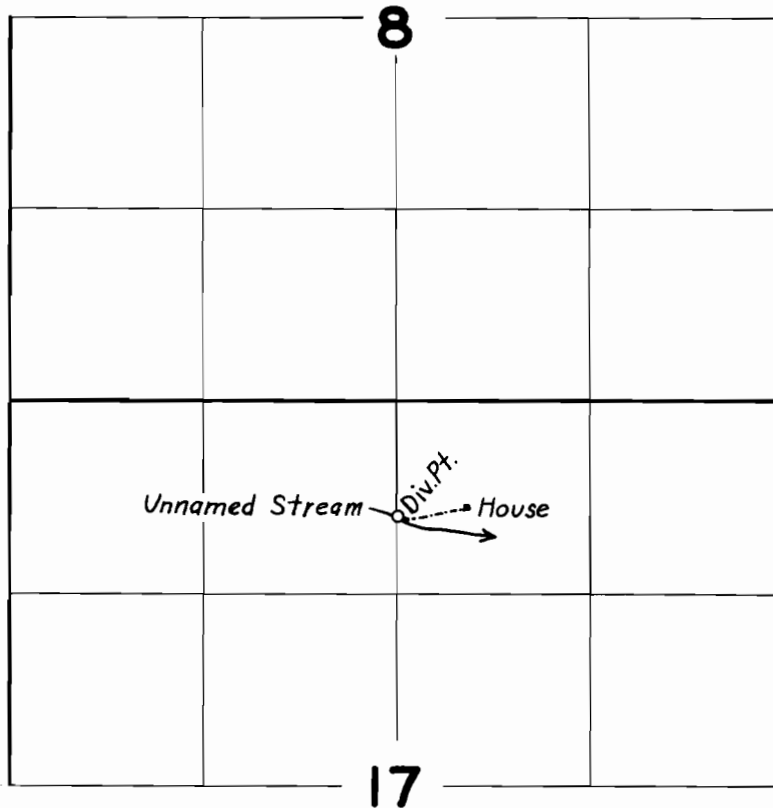

FINAL PROOF SURVEY UNDER

Application No. 20317..... Permit No. 15850.....
IN NAME OF

Mrs. Margaret Thiele Gamble

Surveyed Sept. 16 1953, by T. Jones