


T13S R. 6 W., W.M.

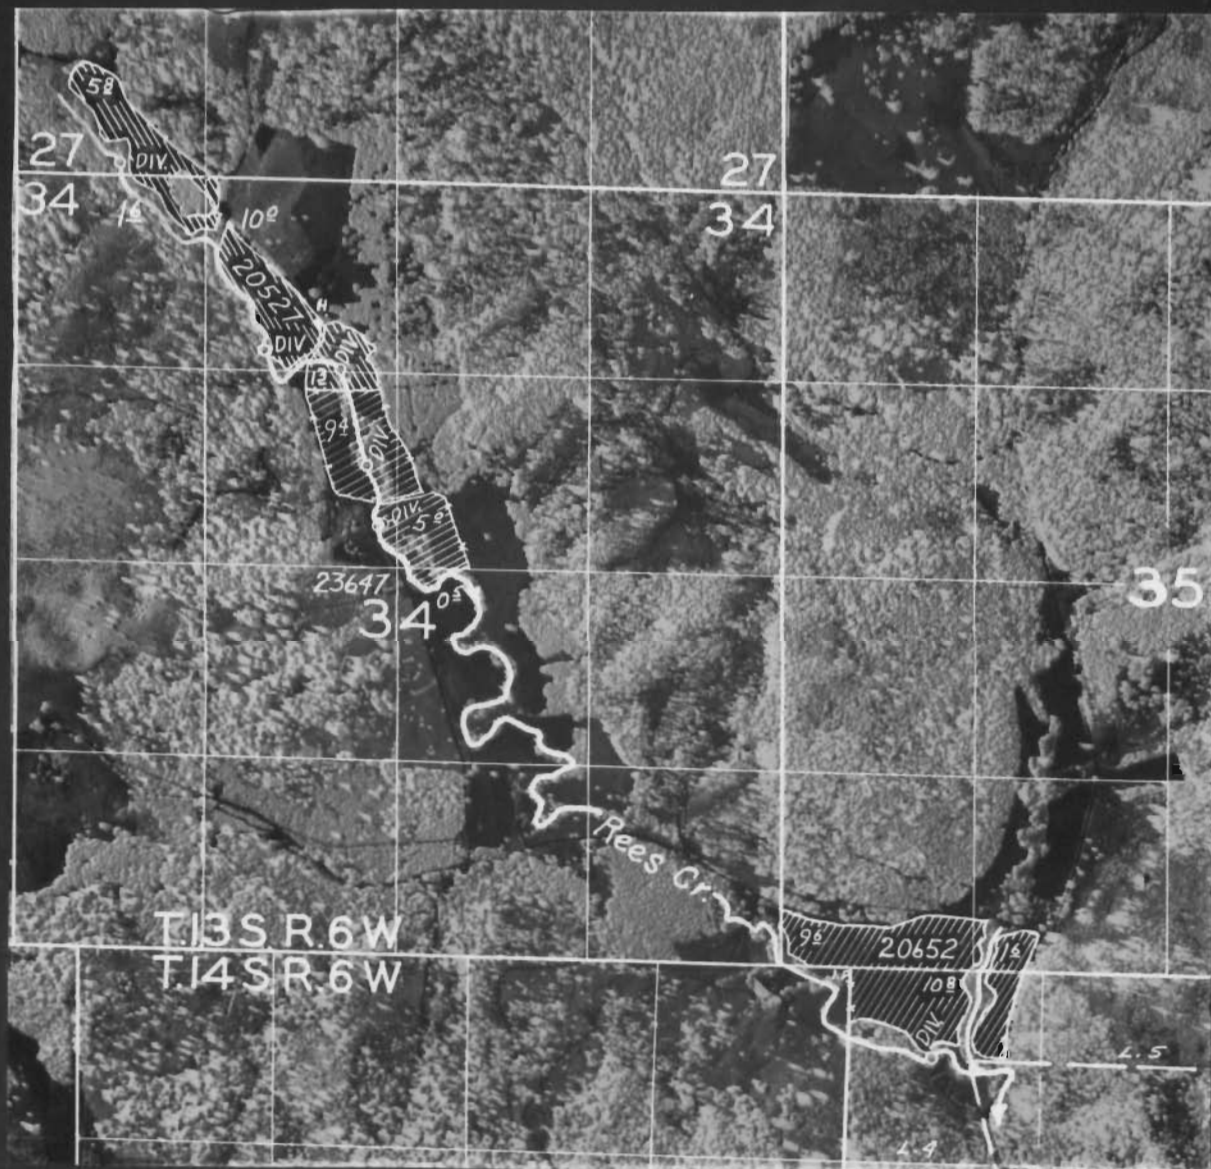

FINAL PROOF SURVEY

UNDER

Application No. 20527 Permit No. 16027
23647 18619
20652 16154

IN NAME OF

Clarence & Lucille E Wilson
Nile J. Pearce Richard Parker

Surveyed Aug 5, 6 19 53, by H.L. Coffman