


T.11 S., R. 7 W., W.M.

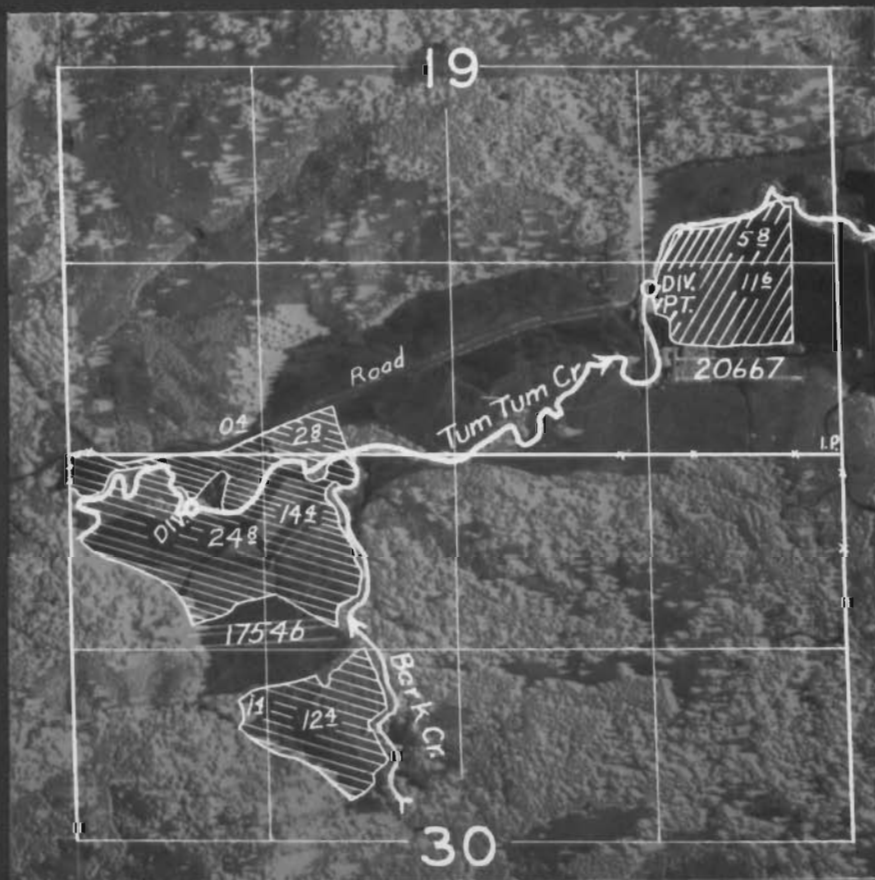

FINAL PROOF SURVEY

UNDER

Application No. 17546 13250
20667 Permit No. 16168
IN NAME OF

Lewis M. Bottorff, Fred C. & Iris L. Ray

Surveyed Aug. 27, 1953, by T. Jones

DFJ-1D-126