


# T.41S. R.13W.WM

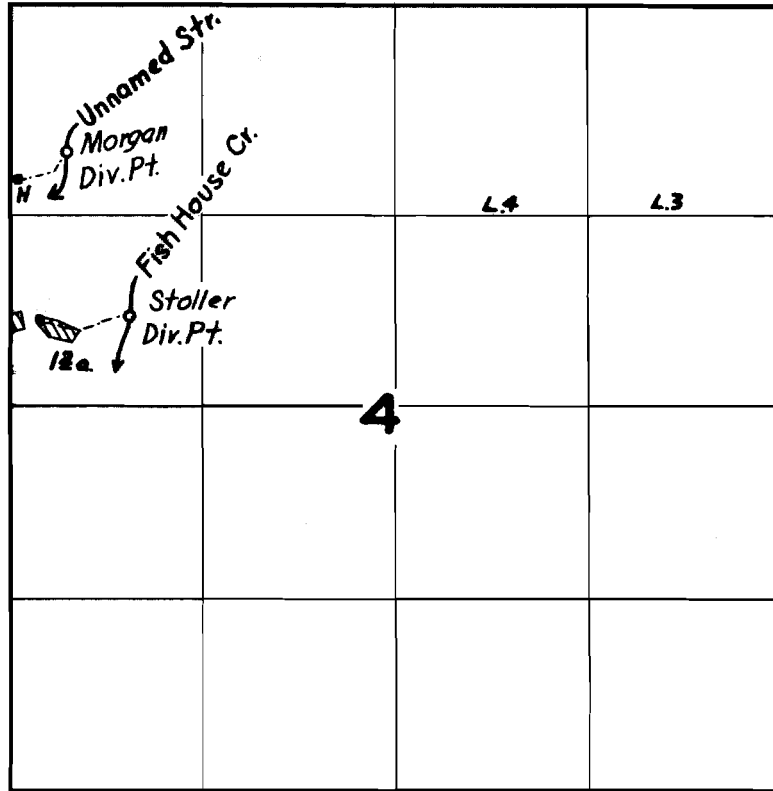

## FINAL PROOF SURVEY

UNDER

22452                      17682  
Application No. 21257..... Permit No. 16659.....

IN NAME OF

Merle E. and Nancy R. Morgan  
Louie Stoller

Surveyed Sept 22 1953, by T. Jones