


T. 5. S., R. 1 E., W. M.

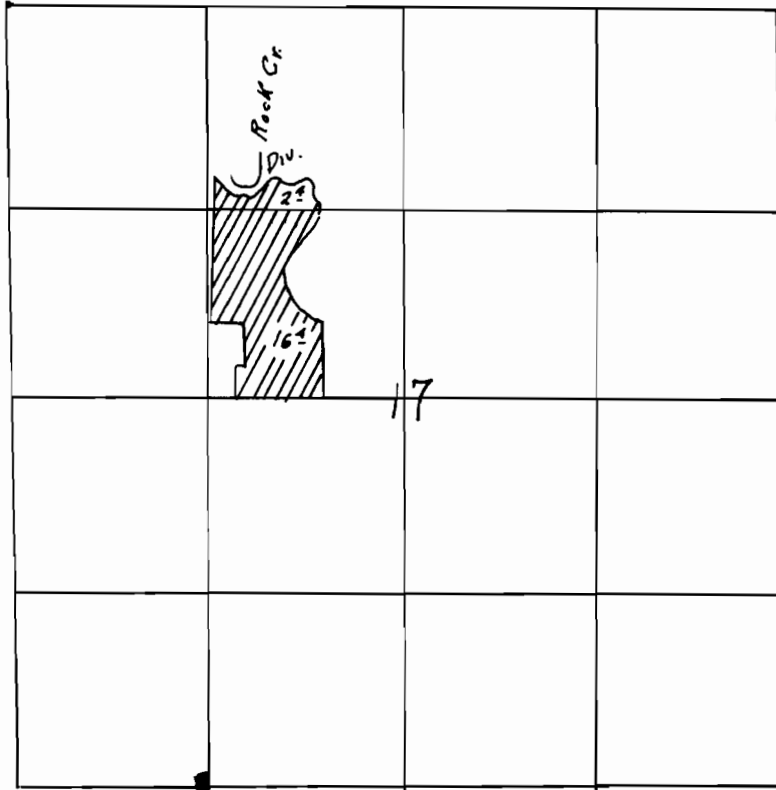

FINAL PROOF SURVEY
UNDER

App. No. 20727 Permit No. 16203
IN NAME OF

OLE I. STEGEN

Surveyed July 8 1953 by T. Jones

DFK-3D-25

Comp. 2/1/54
L.C.