


# T.31 S. R. 15 W.W.M.

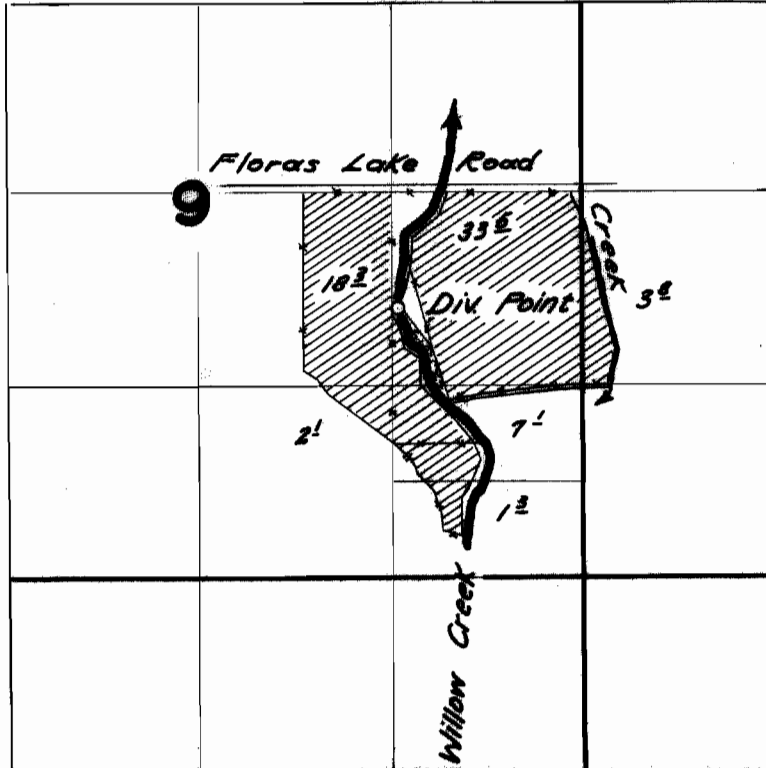

## FINAL PROOF SURVEY UNDER

Application No. 20815 ..... Permit No. 16288.....  
IN NAME OF

Arthur E Strain

Surveyed Sept 24 1953., by H.L. Coffman