


T.38S.R.14W.WM

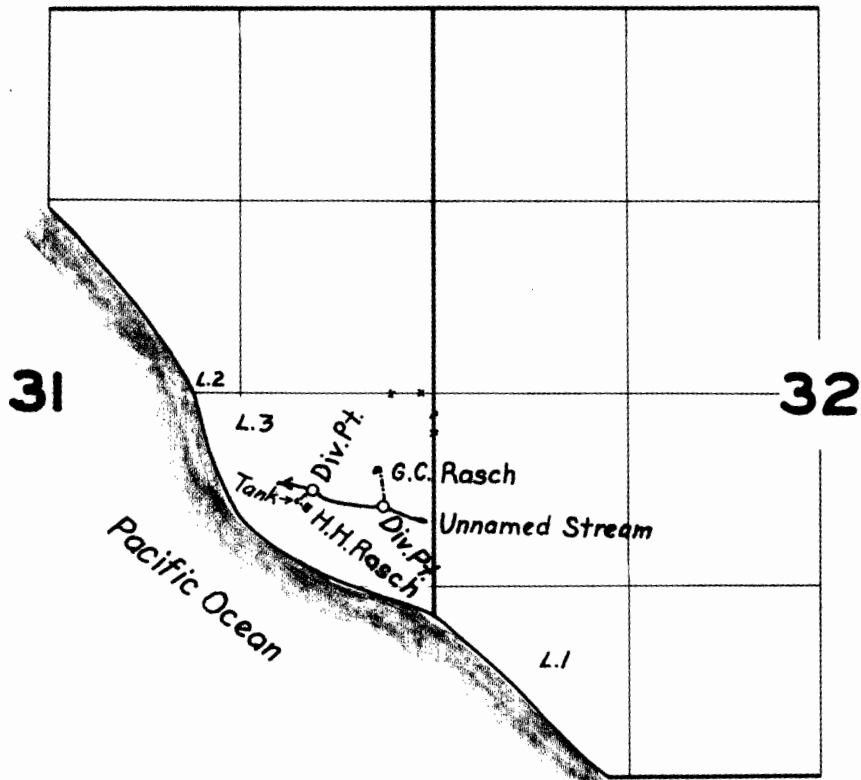

## FINAL PROOF SURVEY

UNDER

Application No. 18397 D Permit No. 11088

IN NAME OF

Grover C. Rasch and Halvor H. Rasch

Surveyed Sept. 16, 1953, by T. Jones