


T.41S.R.13 W.W.M.

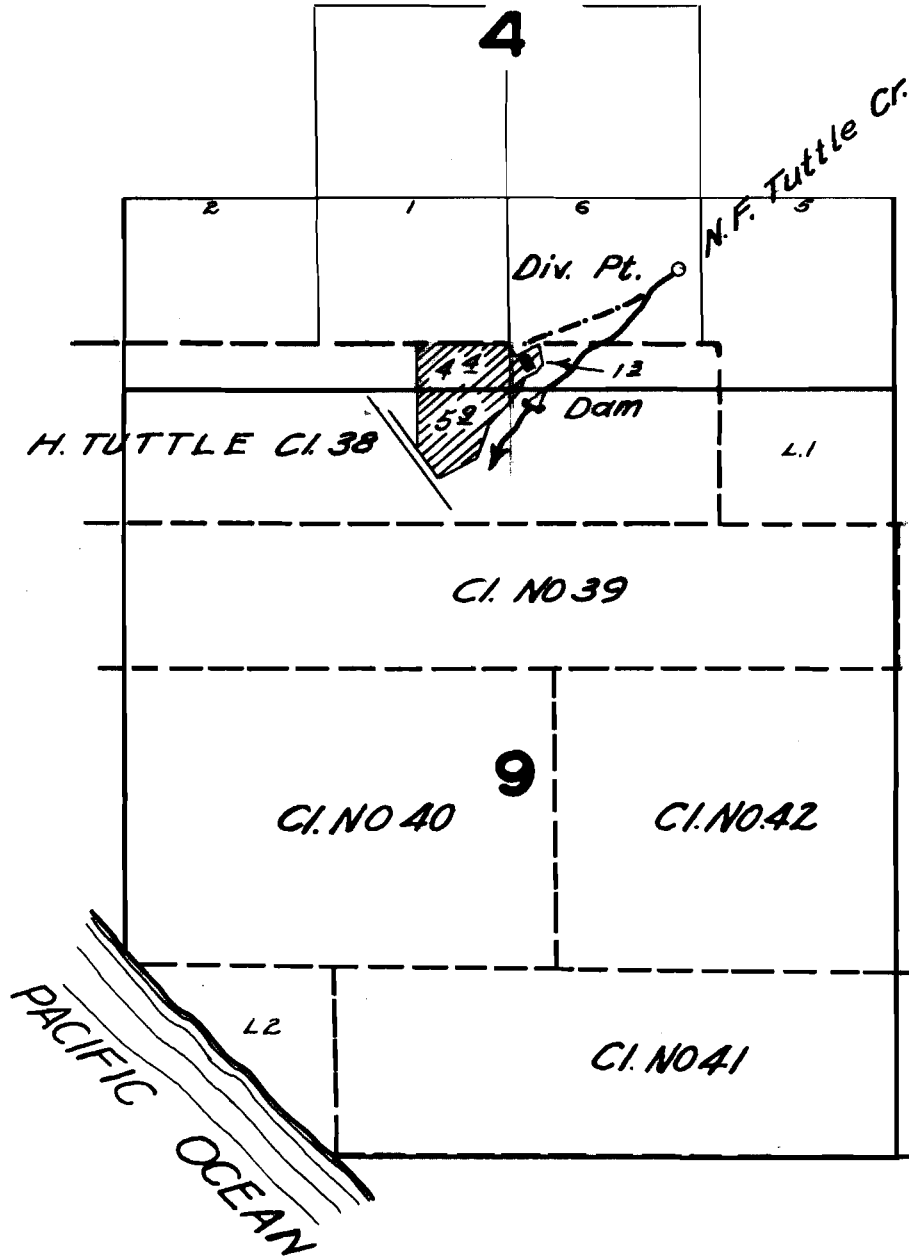

FINAL PROOF SURVEY

UNDER

Application No. 21293 Permit No. 16696

IN NAME OF

N.V. Stromen

Surveyed Sept 21 19 53 by H.L. Coffman