


T. 5 S., R. 1 E., W. M.

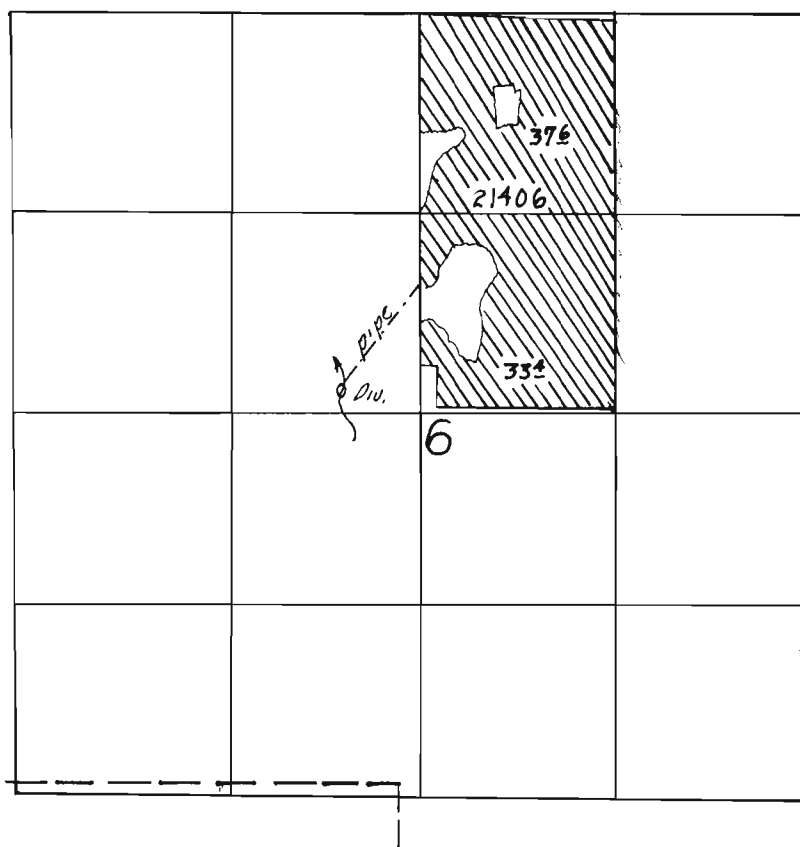

FINAL PROOF SURVEY
UNDER

App. No. 21406 Permit No. 16775
IN NAME OF

Anthony Cacka

Surveyed July 9, 1953 by H. L. Coffman

DFK-3D-22