


21447

T. 4 S., R. 2 E., W.M.

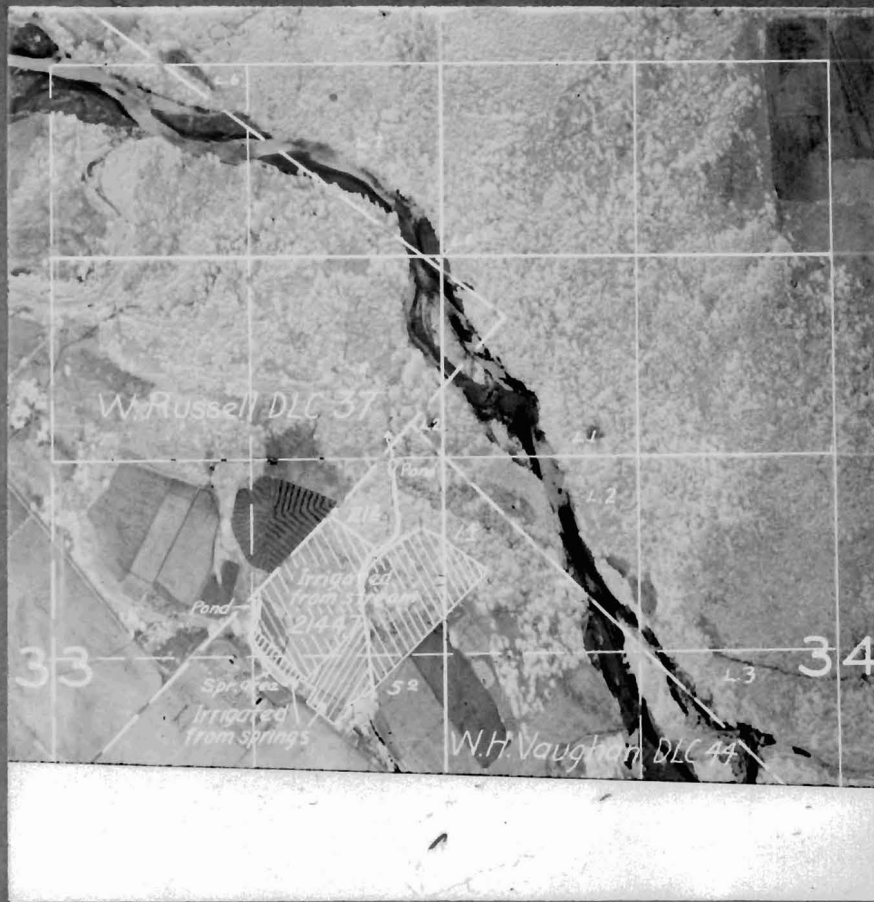

**FINAL PROOF SURVEY**  
 UNDER

Application No. 21447 Permit No. 16826  
 IN NAME OF

CHARLES GRANT BURDEN

Surveyed June 1, 1953, by H. L. Coffman

DFK-3D-158