


2325
T. 3 S., R. 1 W., W.M.

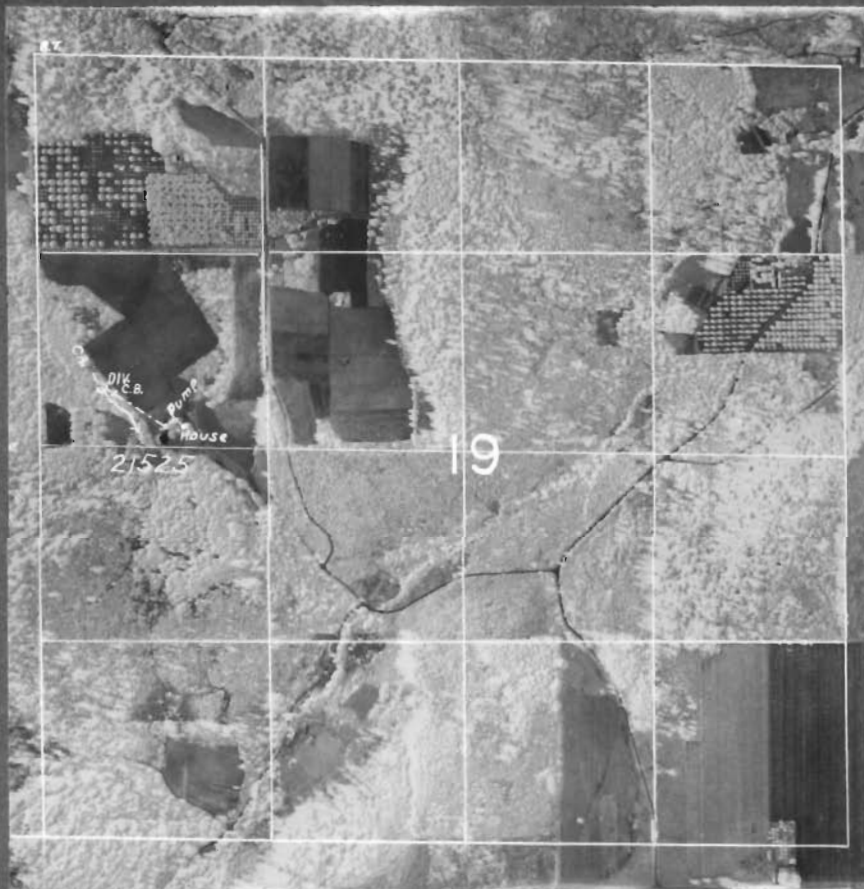

FINAL PROOF SURVEY
UNDER

Application No. 21525 Permit No. 16879
IN NAME OF

THAYER H. CLARK

Surveyed April 24 1953, by H. L. Coffman

DFK-2D-45