


T. 4 S., R. 2 E., W.M.

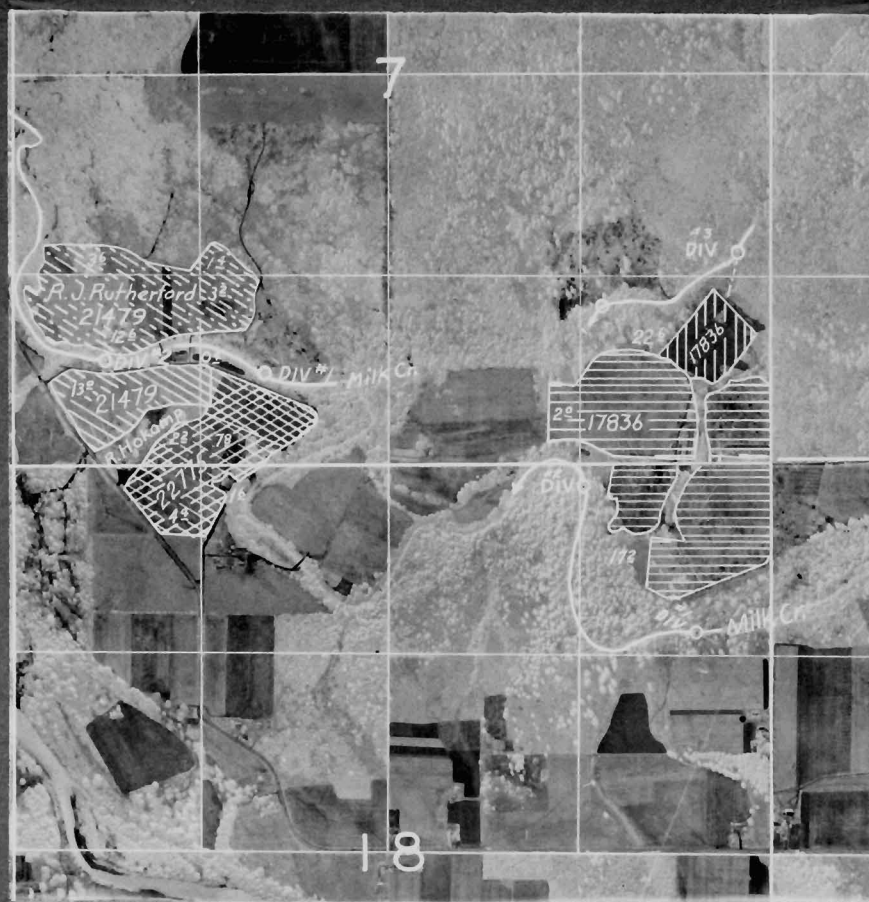

FINAL PROOF SURVEY
UNDER

Application Nos.	Permit Nos.
17836	13699
21479	16847
22775	17940


IN NAME OF
HENRY & PEARL FREEMAN

HERBERT F. & ROVILLA HOKAMP & RUSSELL J. RUTHERFORD
Surveyed May 26 1953, by H. L. Coffman

DFK-3D-121

T.4S.R.2E.W.M.

*Do Not Print
See Photo # DFR 3D-121*

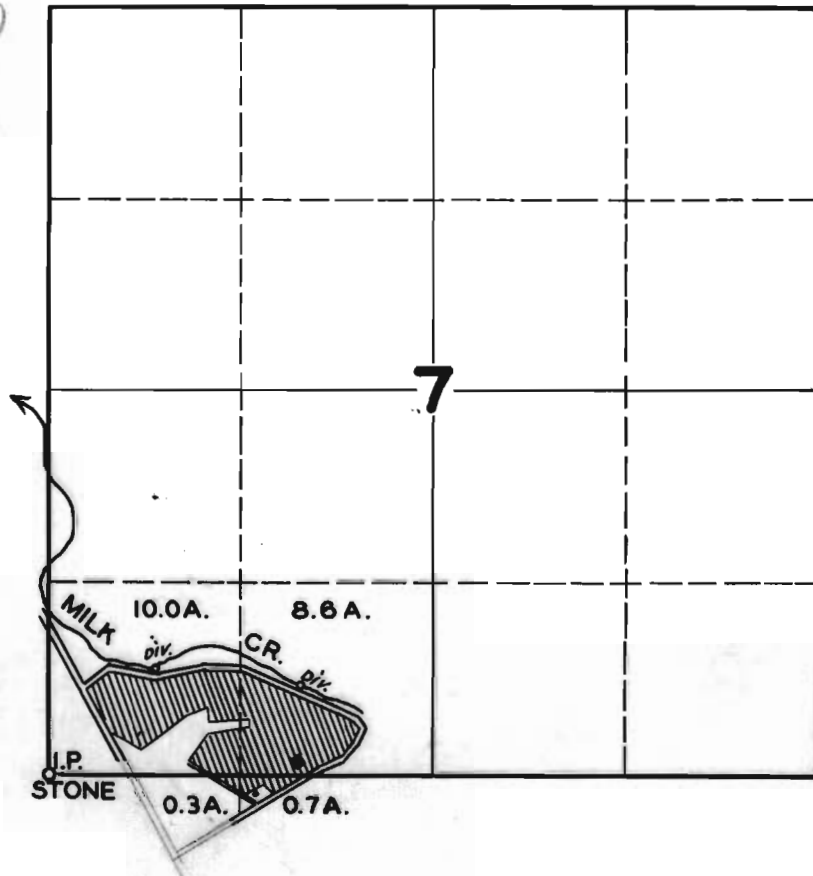

FINAL PROOF SURVEY
UNDER

Application No. **21479** Permit No. **16847**
IN NAME OF

A. J. MILFORD

Surveyed **AUG. 5** 1948, by **JAS. E. BUNNELL**