


T. 40S. R. 13 & 14 W. WM.

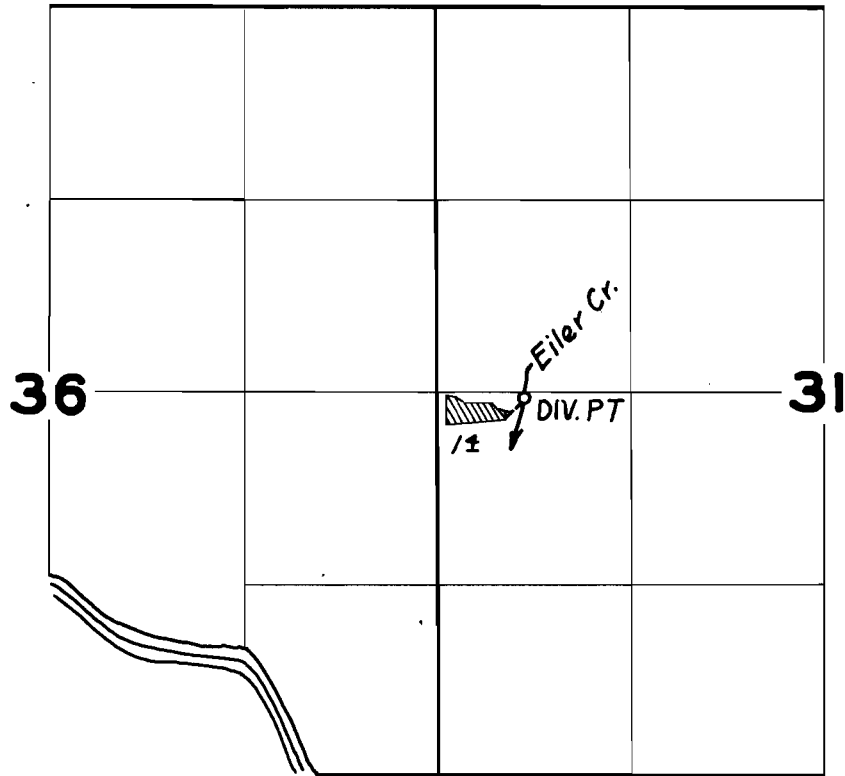

FINAL PROOF SURVEY

UNDER

Application No. 21788..... Permit No. 17141.....

IN NAME OF

..... A. B. & Lillian L. Thomas

Surveyed Sept. 17 1953, by T. Jones.....