


T. 27 S., R. 7 W., W. M.

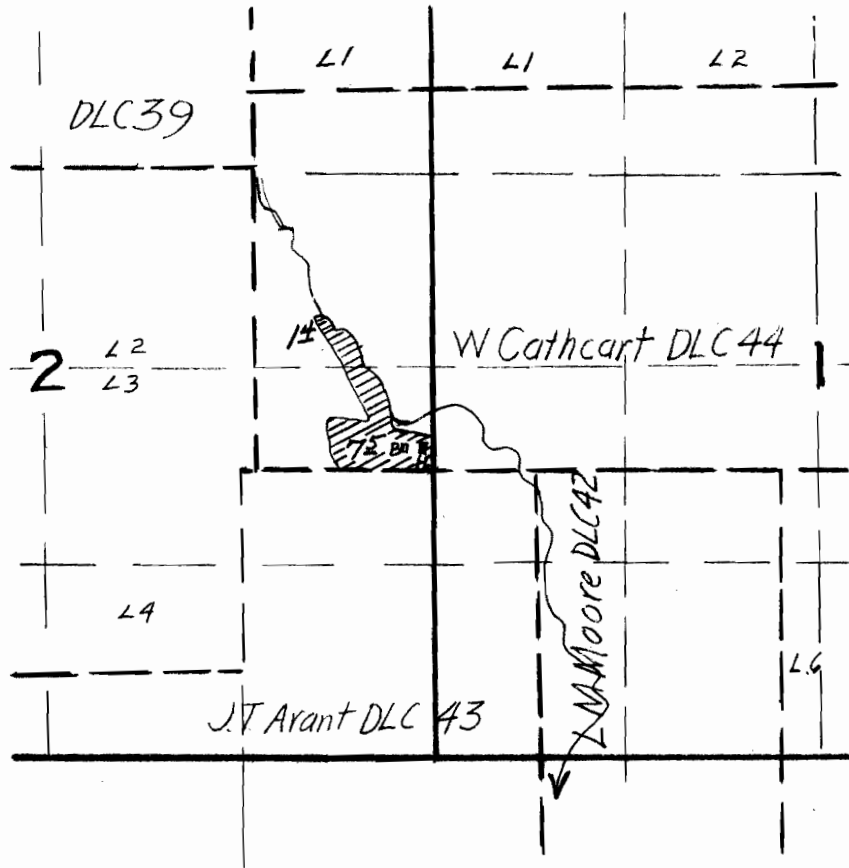

FINAL PROOF SURVEY  
UNDER

Application No 21861 Permit No 17193  
IN NAME OF

J. F. & LAURA WARDWELL

Surveyed May 14 1953 by H. L. Coffman

DB-HW-15-12