


22032

T. 2 S., R. 1 E, W.M.

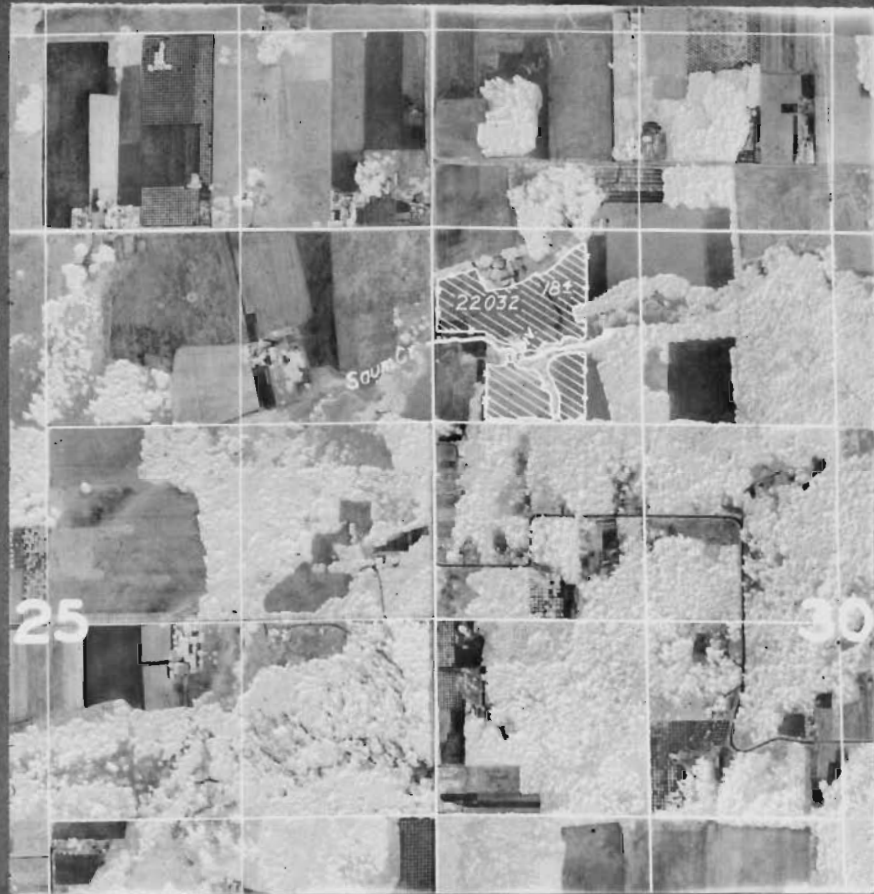

FINAL PROOF SURVEY
 UNDER

Application No. 22032 Permit No. 17356
 IN NAME OF
 EARL SAGERT

Surveyed June 29 1953, by H. L. Coffman

DFK-3D-09