


22074

T. 28 S., R. 6 W., W. M.

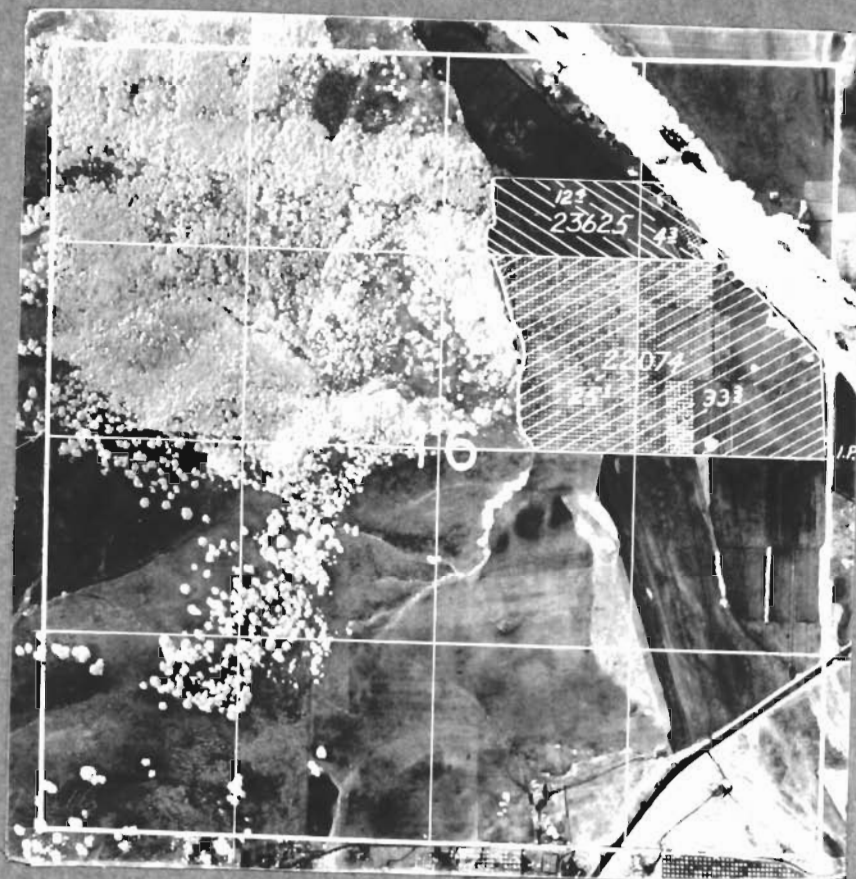

# FINAL PROOF SURVEY

UNDER

Application No. 22074 Permit No. 17330  
23625 18628

IN NAME OF

PAUL H. HELWEG & FREDERICK W. HOFFMEISTER

Surveyed May 8 1953, by H. L. Coffman

DB-HW-18-67