


T. 35S., R. 1W., W.M.  
SEC. 9

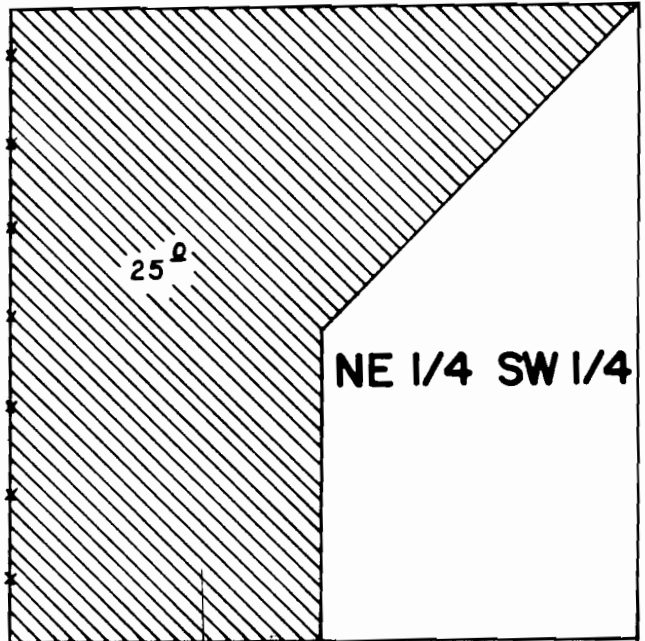


NE 1/4 SW 1/4

SCALE: 1" = 400'

SW 1/4 SW 1/4

LOT 1

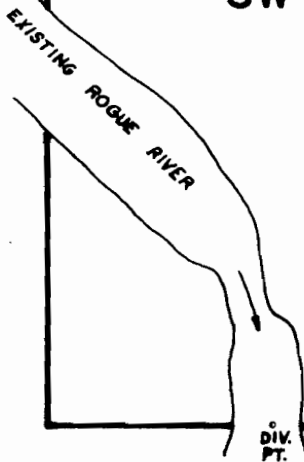

DIV. PT.

DIV. PT.: 5' N. & 840' W. from the S.E. COR. of LOT 1, SW 1/4 SW 1/4, SEC. 9.



**FINAL PROOF SURVEY**  
UNDER

TRANSFER NO. 4291

Application No. .... Permit No. ....

IN NAME OF

..... DANIEL & FRANCES BROWN .....

Surveyed JULY 6... 19.83, by B.S. JAMES.....