


T. 3 S., R. 1 W., W.M.

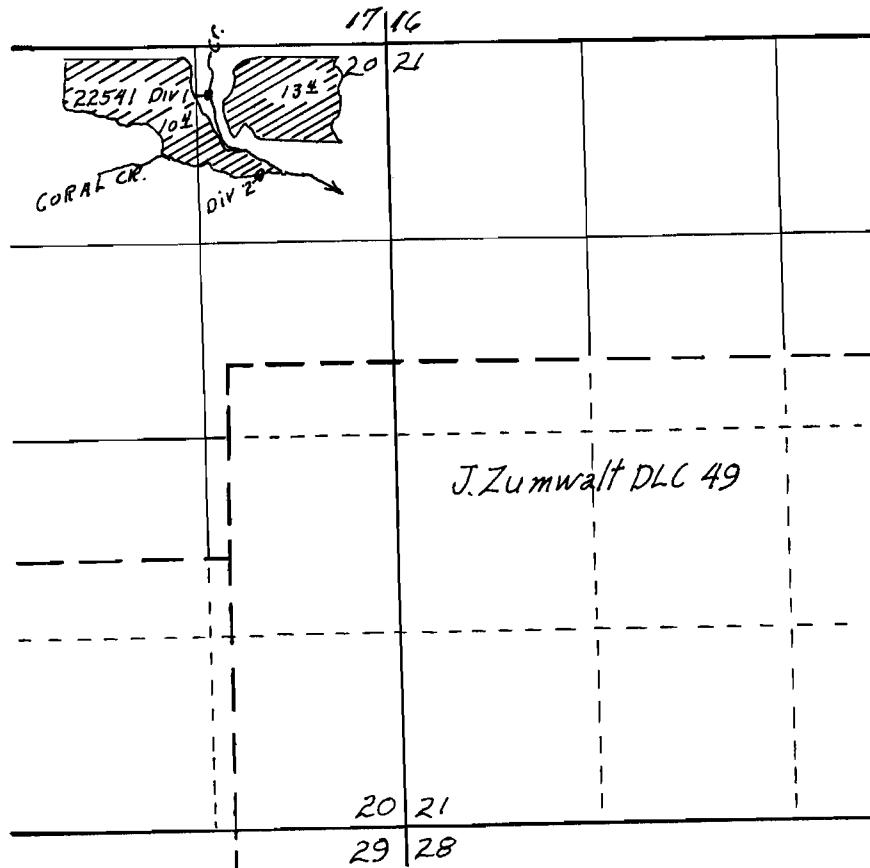

FINAL PROOF SURVEY  
UNDER

Application No. 22541 Permit No. 17753  
IN NAME OF  
WILLIAM RHODE

Surveyed April 23 1953, by H. L. Coffman

DFK-2D-60