


T. 3 S., R. 2 E., W.M.

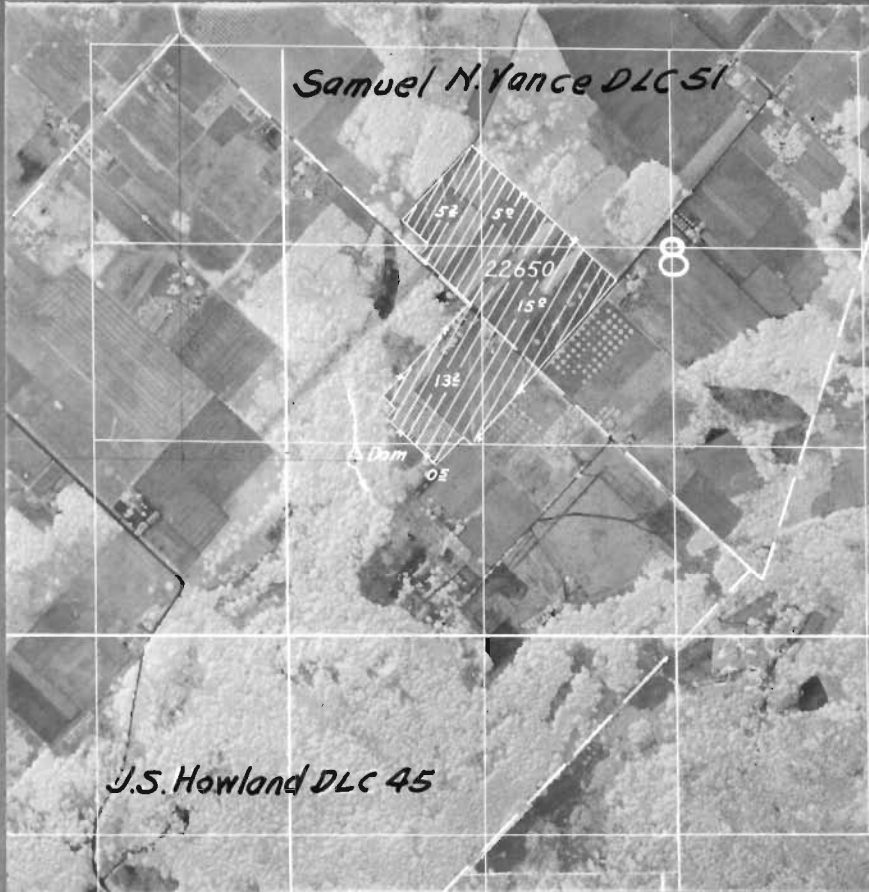

**FINAL PROOF SURVEY**  
UNDER

Application No. 22650 Permit No. 17921  
IN NAME OF

RUDOLPH PAVLINAC

Surveyed May 19 1953, by H. L. Coffman

DFK-3D-127