


T.3S. R.2W.W.M.

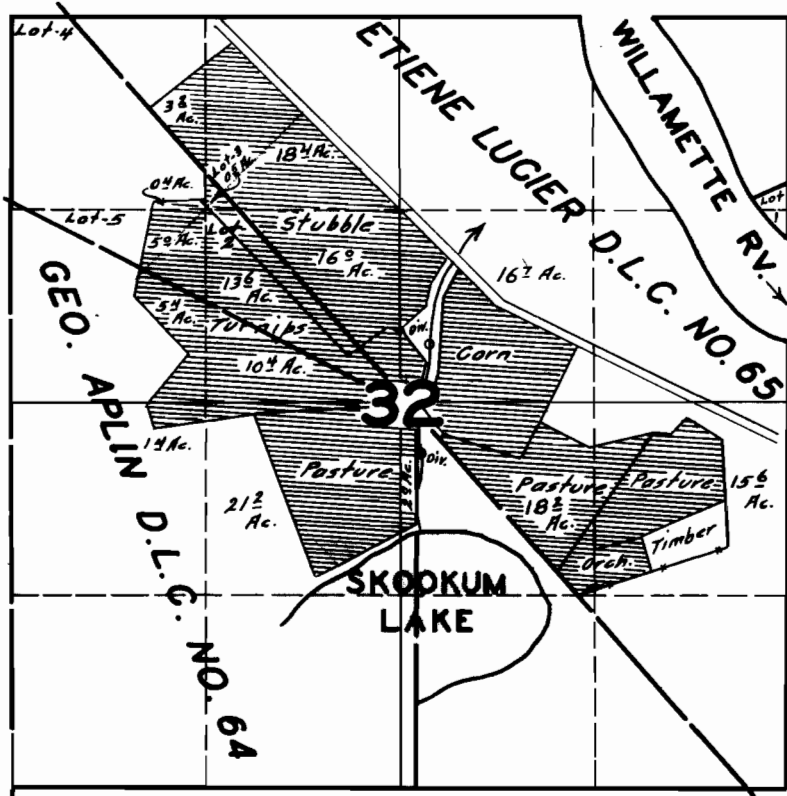

FINAL PROOF SURVEY

UNDER

Application No. 19312 Permit No. 14895

IN NAME OF

HILLER BROS

Surveyed APR. 4, 1946, by