


T.14S.R.8W.W.M.

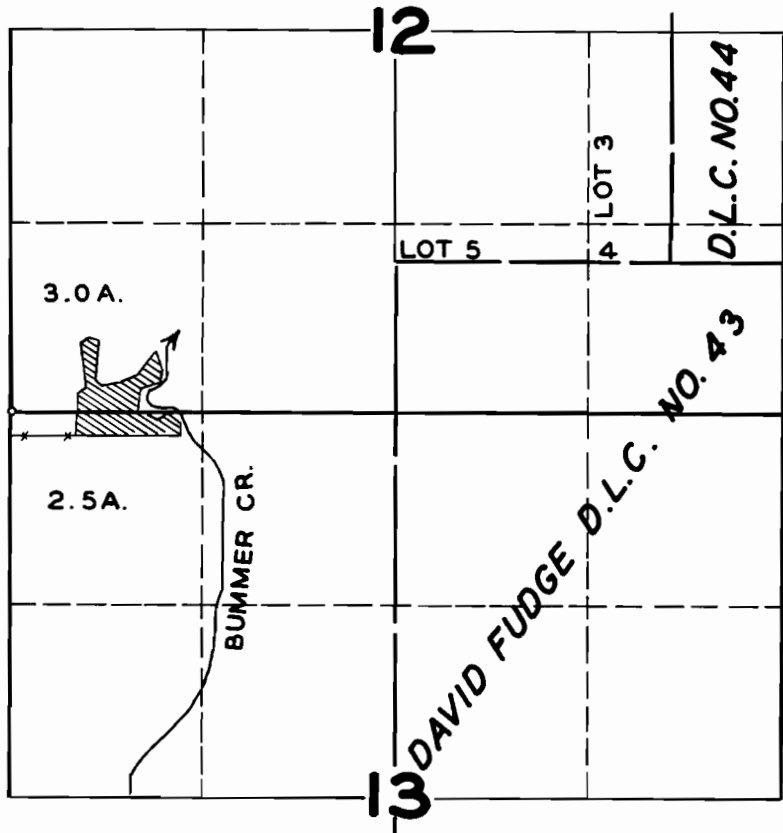

FINAL PROOF SURVEY

UNDER

Application No. 20274 Permit No. 15816

IN NAME OF

ANDREW ANDERSON

Surveyed JUNE 28 1948, by JAS. E. BUNNELL