


T. ... R. ... W.M.

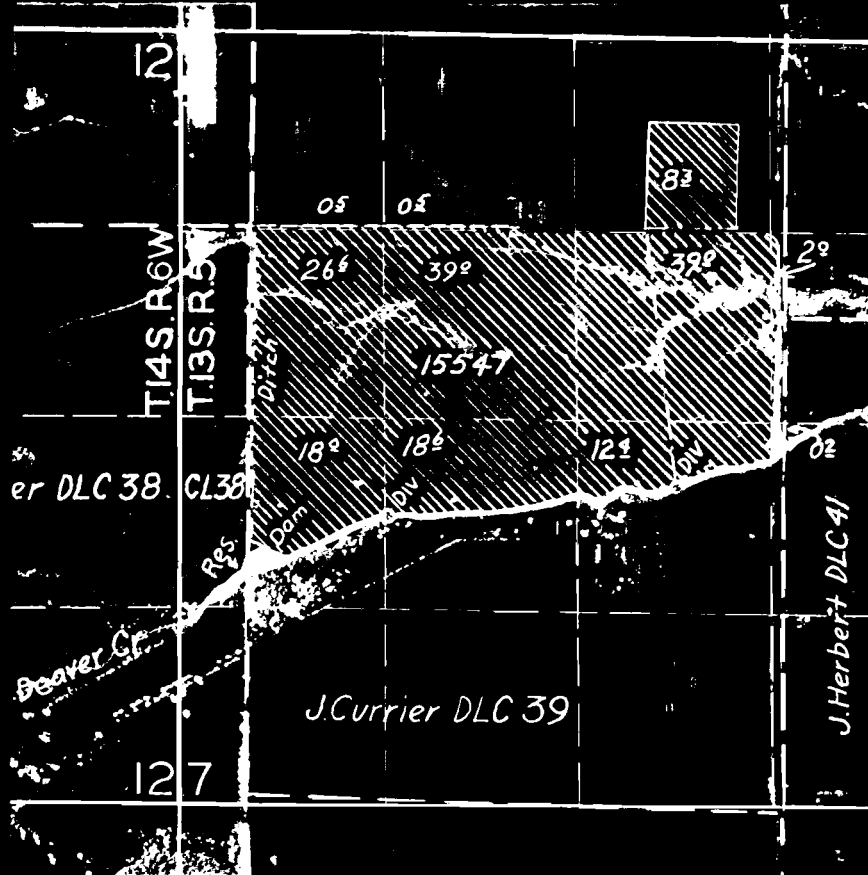

FINAL PROOF SURVEY

UNDER

Application No. Permit No.
IN NAME OF

Surveyed 19 , by