


T.37 S.R.15W.W.M.

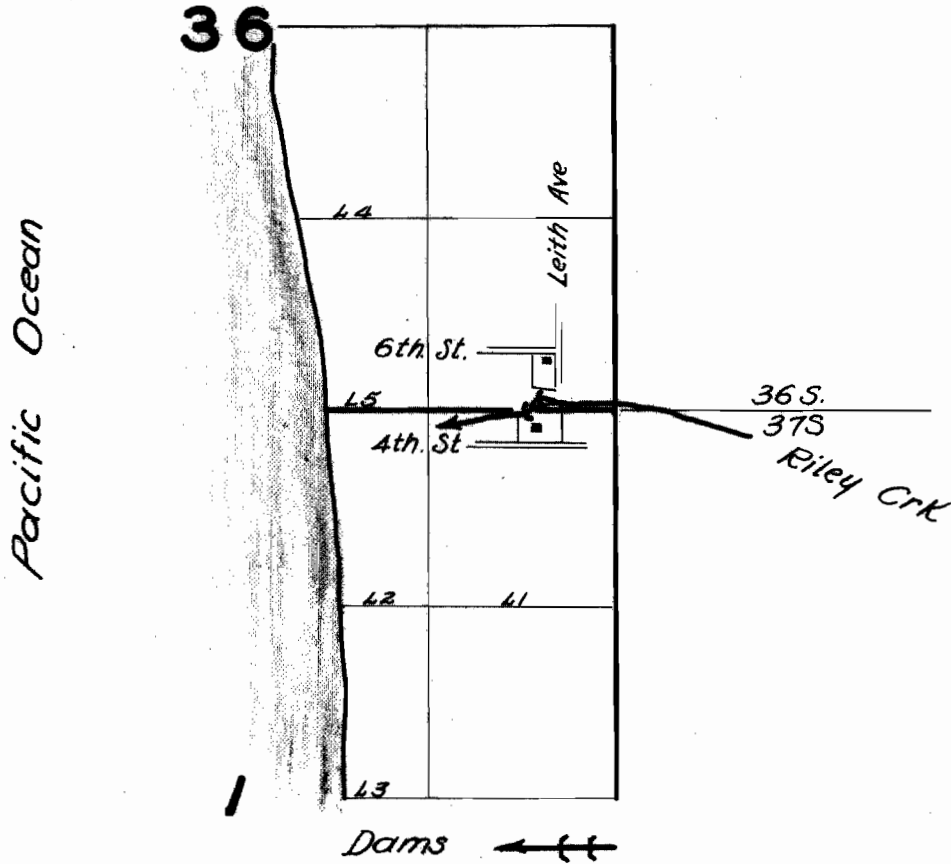

FINAL PROOF SURVEY
UNDER

Application No. 20926..... Permit No. 16387.....
IN NAME OF

H.W. Crook and Richard Buffington

Surveyed Sept 16 1953., by H.L. Coffman