


T.24.S.R.12W.W.M.

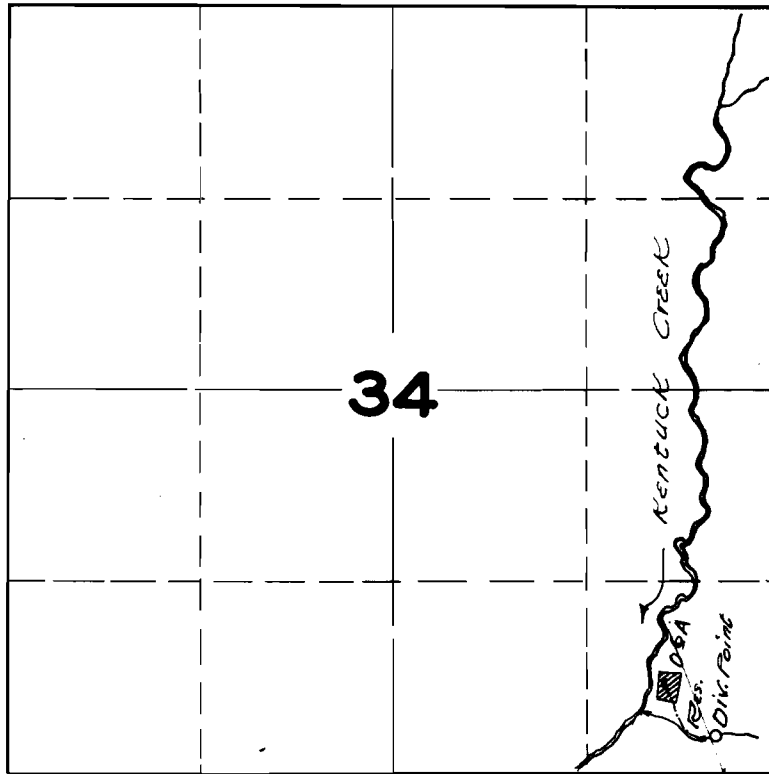

FINAL PROOF SURVEY
UNDER

Application No. 19722.. Permit No. 15294..
IN NAME OF

.....GRACE G.&CHAS.C.HOFER.....

Surveyed AUG. 24 1949., by H.L.COFFMAN..