


T.3S. R. 4W. W.M.

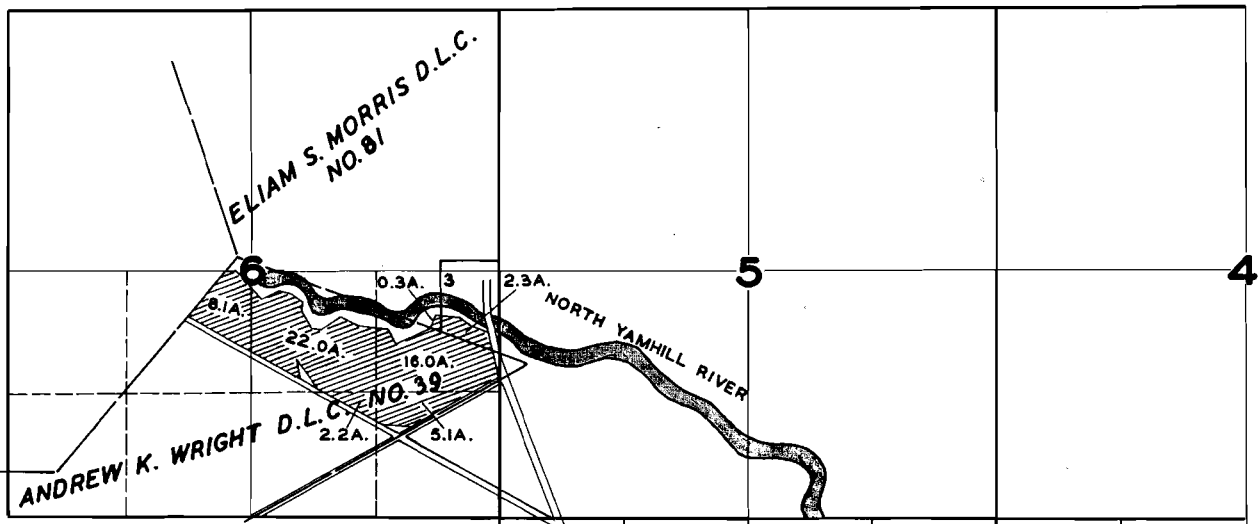

**FINAL PROOF SURVEY**  
UNDER

Application No. 17,795 Permit No. 13,474

IN NAME OF

THEODORE M. BERNARDS

Surveyed MAY 2, 1947, by JAS. E. BUNNELL

