


T.4 | S. R. | 3 W. W. M.

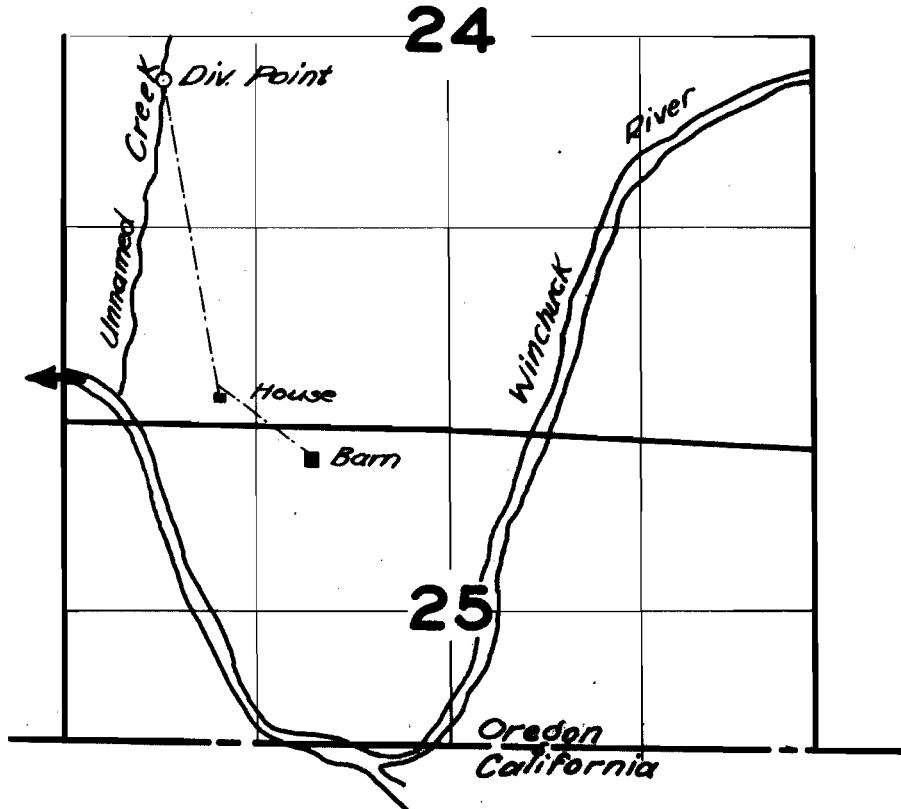

**FINAL PROOF SURVEY**

UNDER

Application No. 21639..... Permit No. 17000.....

IN NAME OF

M. L. DeMartin

Surveyed Sept 17 19 53, by H. L. Coffman