


T.38S.R.14W.WM

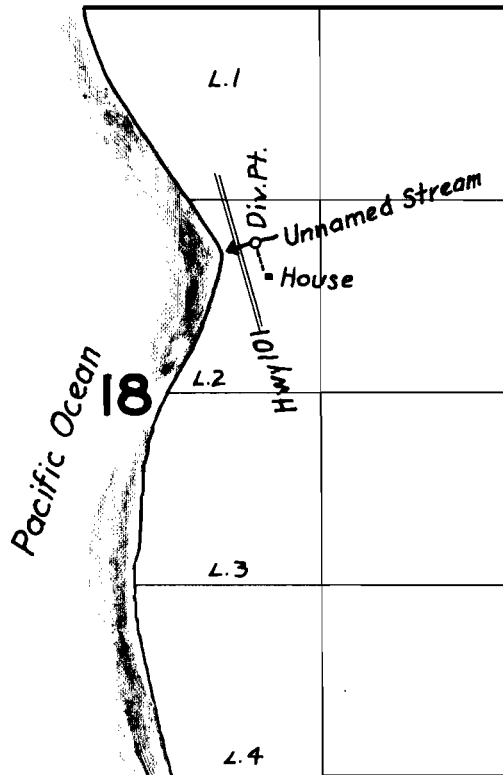

FINAL PROOF SURVEY UNDER

Application No. 21732 Permit No. 17106
IN NAME OF

Stanley A. & Virginia E. Fendrick

Surveyed Sept 15 1953, by T. Jones