


23756

T. 30 S., R. 5 W., W. M.

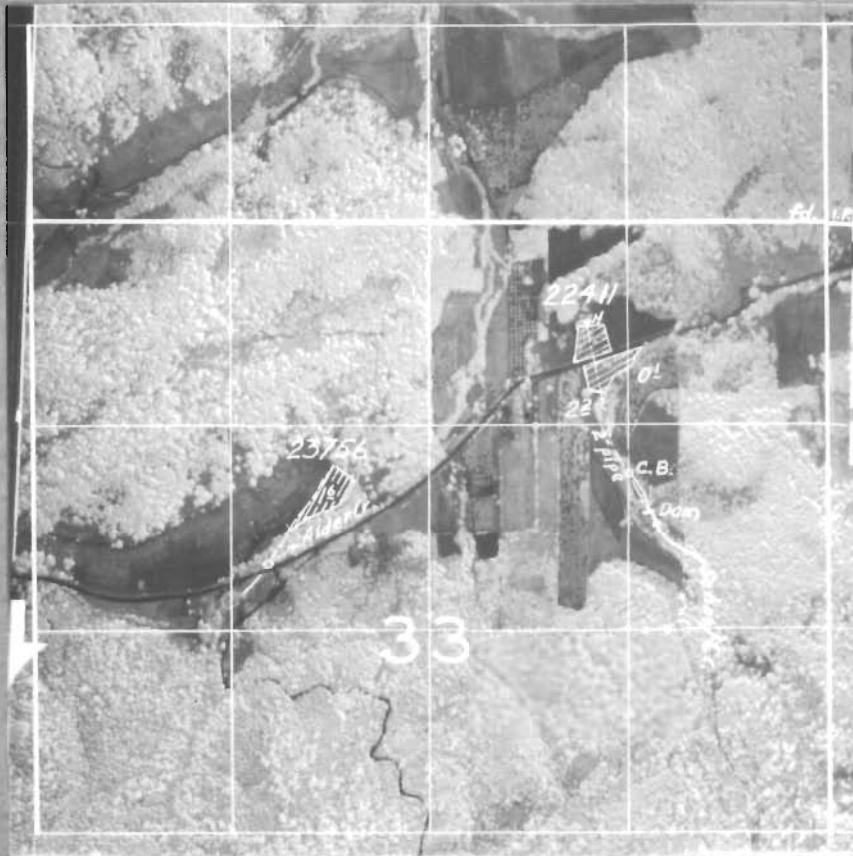

FINAL PROOF SURVEY

UNDER

Application No. 22411 23756 Permit No. 17666 18812

IN NAME OF

CHARLES LILJA & ROBERT E. PROCTOR

Surveyed May 13 1953, by H. L. Coffman & T. Jones
DA 3-12