


T. 11 S., R. 7 W., W.M.

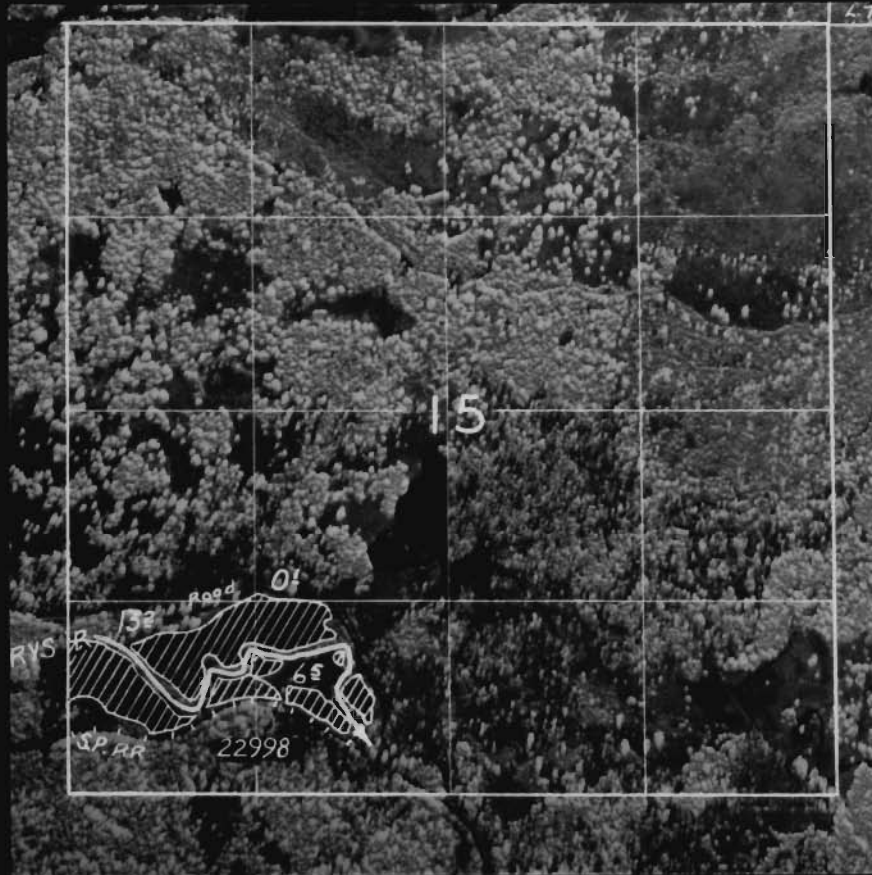

FINAL PROOF SURVEY

UNDER

Application No. 22228 Permit No. 18135
IN NAME OF

O.H. & Adeline W Stiles

Surveyed Sept 8 1933, by T. Jones

DFJ-3D-175