


T. 40S. R 14W. WM

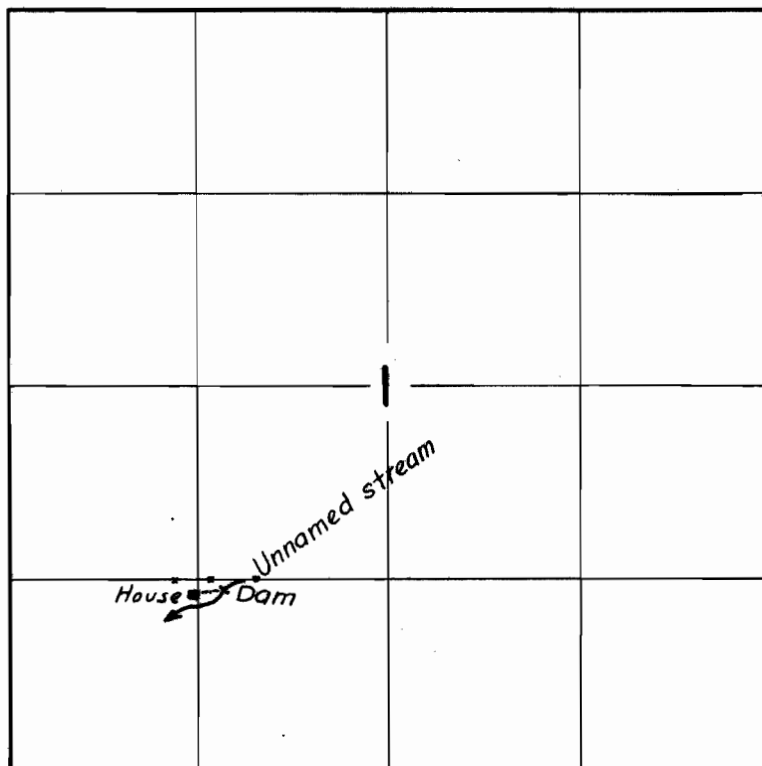

FINAL PROOF SURVEY
UNDER

Application No. 23066..... Permit No. 18162.....
IN NAME OF

Priscilla M Robinson

Surveyed Sept. 17 1953, by T. Jones